All existing building fabric, services, structural steelwork, etc. shown indicative only acquired from McDL Surveys Ltd information

NOTES: Do not scale this drawing. All dimensions to be checked on site prior to commencement or manufacture.

Key Plan (nts)

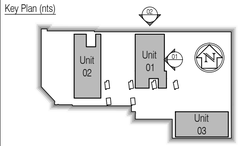

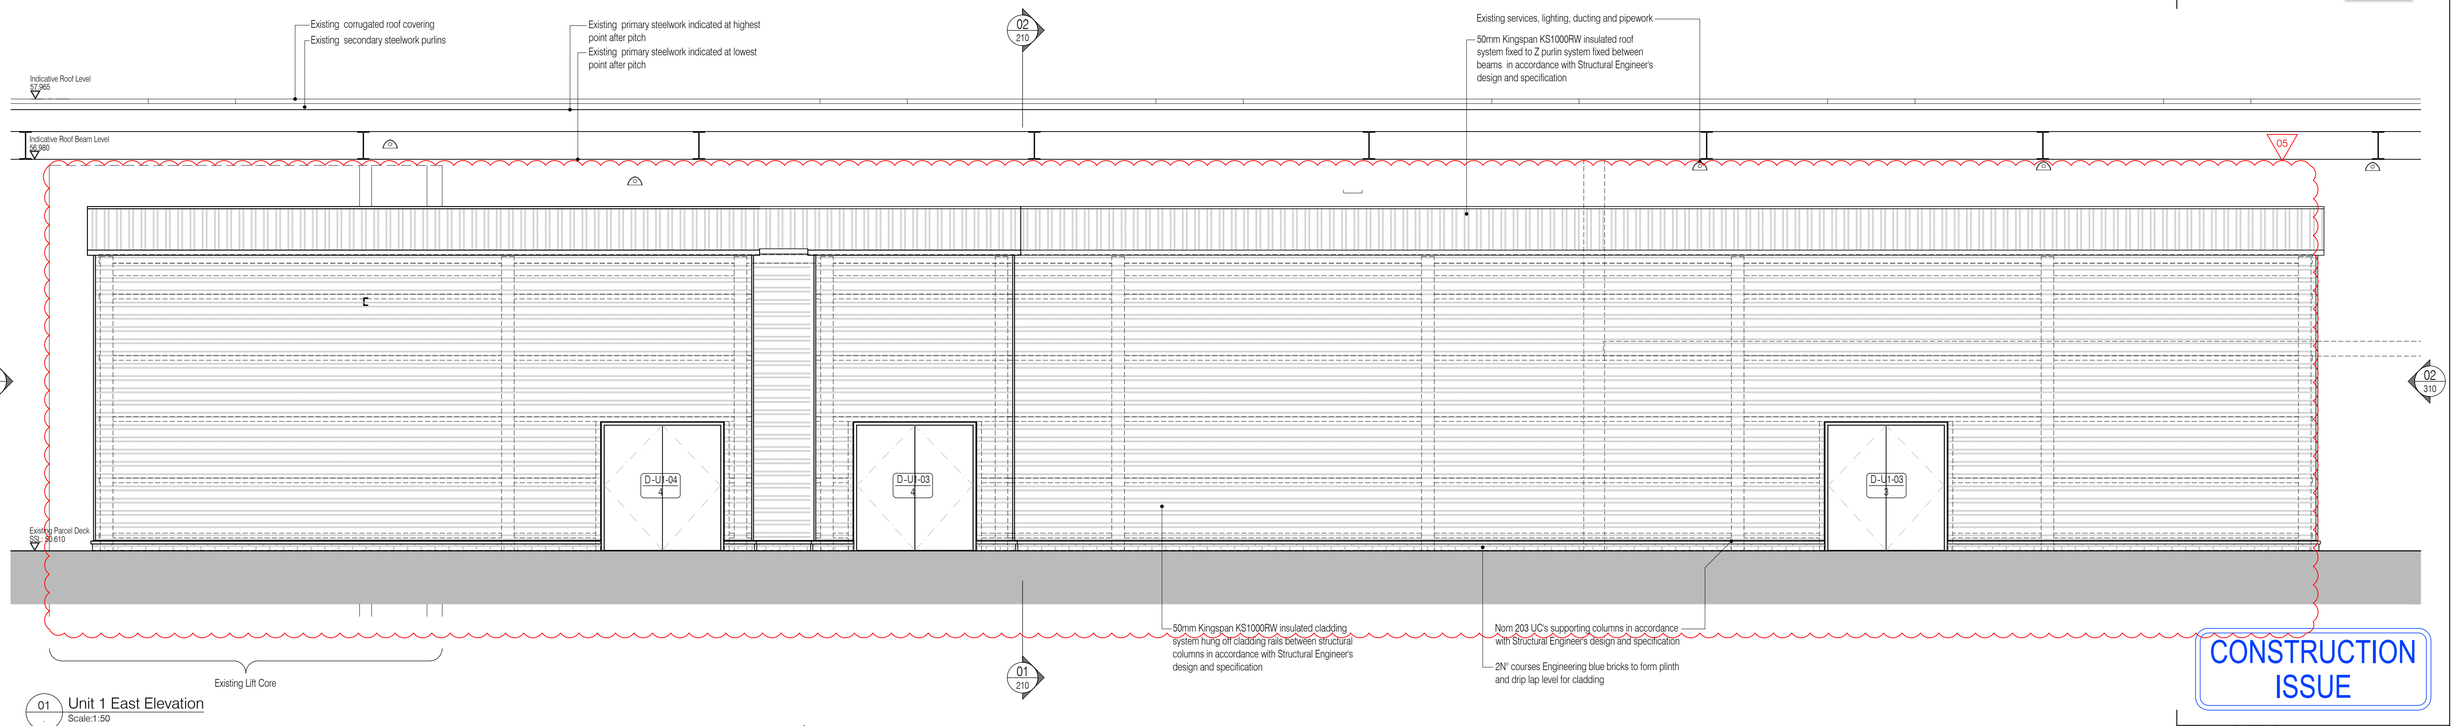

01 Unit 1 East Elevation
Scale:1:50

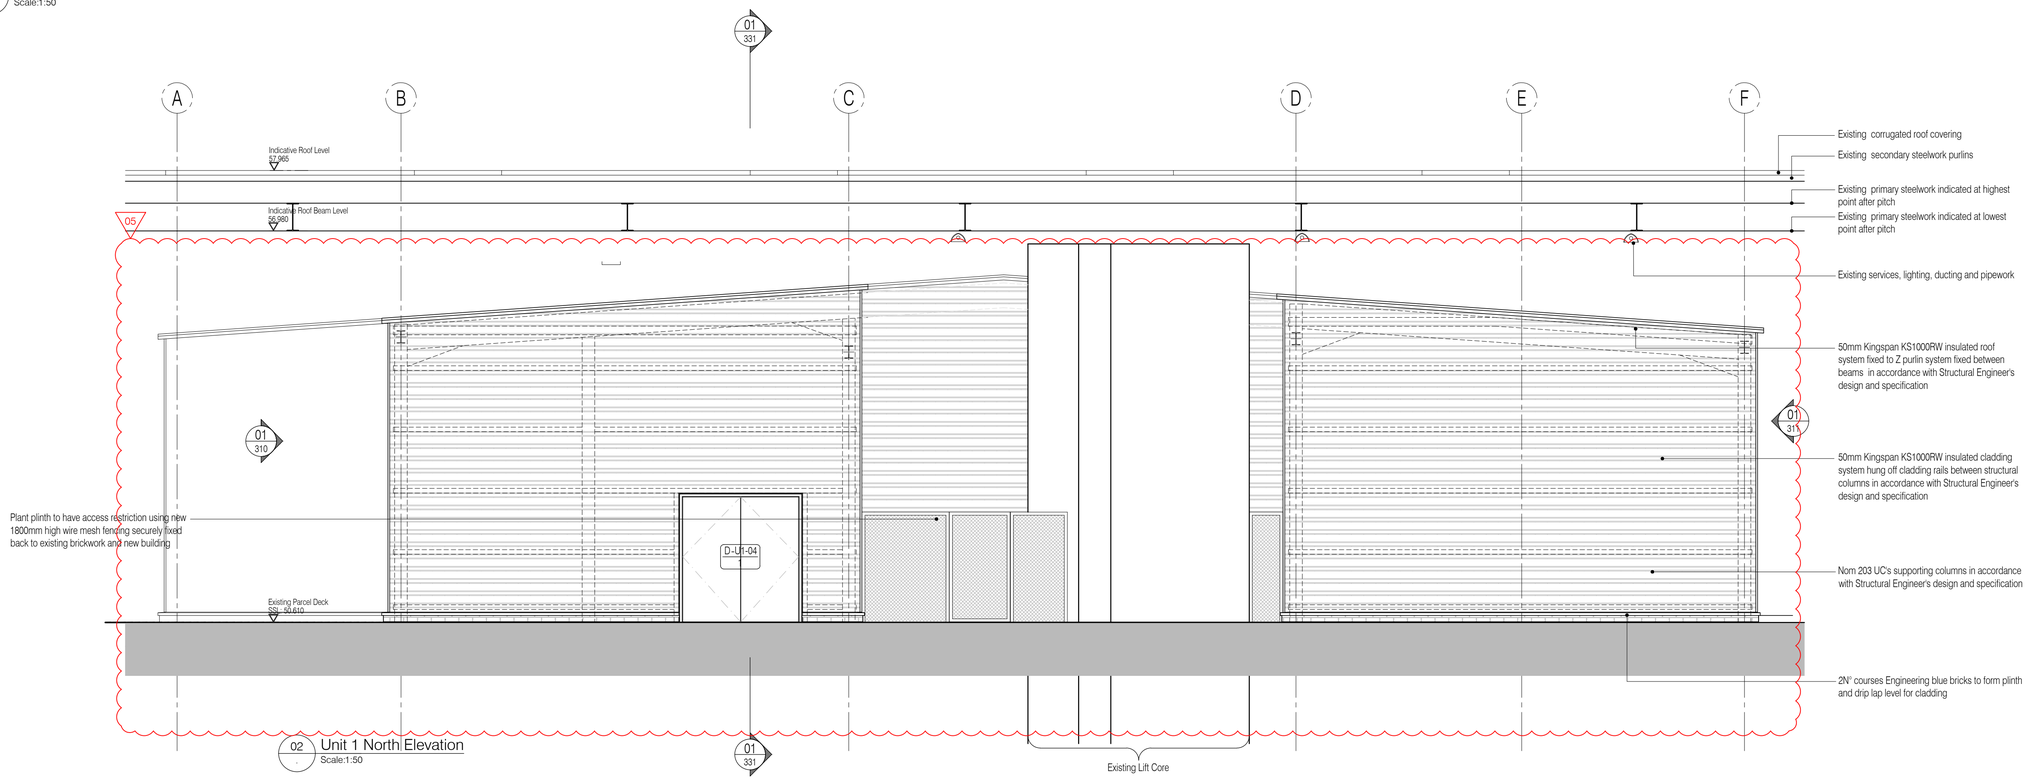

02 Unit 1 North Elevation
Scale:1:50

CONSTRUCTION ISSUE

Rev	Date	By	Chk	Comment
05	08.03.11	RKC	JAS	Revised to suit structural redesign
04	22.11.10	JAS	AC	Issued for Construction
03	08.10.10	RKC	JAS	Issued for Tender.
02	05.10.10	RKC	JAS	General revisions
01	29.09.10	RKC	JAS	Refs added. Issued for approval.

BRINGING IDEAS TO LIFE

FRANKHAM

Frankham Consultancy Group Limited
21 Perrymount Road
Haywards Heath RH16 3TP
t 01444 444900 f 01444 455542
enquire@frankham.com
www.frankham.com

Client: Network Rail / railgourmet

Project Title
Euston Station
Parcel Deck
Rail Gourmet Facility

Drawing Title
General Arrangements
West & North Elevations
Unit 1

Drawn by:	Scale:	Date:
RKC	1:50@A1	23.09.10
Designed by:	Checked by:	Approved by:
FCG	JAS	AC

File Ref.: X:\FRANKHAM\2_CAD\440270-EUSTON\ARCH\300_399_ELEVATIONS\440272-A-311.DWG - 20061114241 20:06:11:14:25:40

Drawing No.	Rev.
440272-A-311	05