




NOTES: Do not scale this drawing. All dimensions to be checked on site prior to commencement or manufacture.

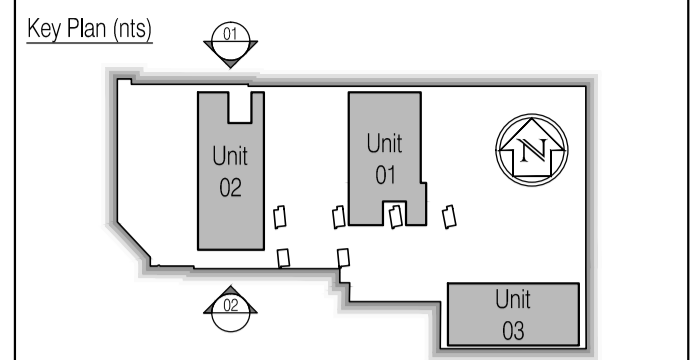

All existing building fabric, services, structural steelwork, etc. shown indicative only acquired from McDL Surveys Ltd information

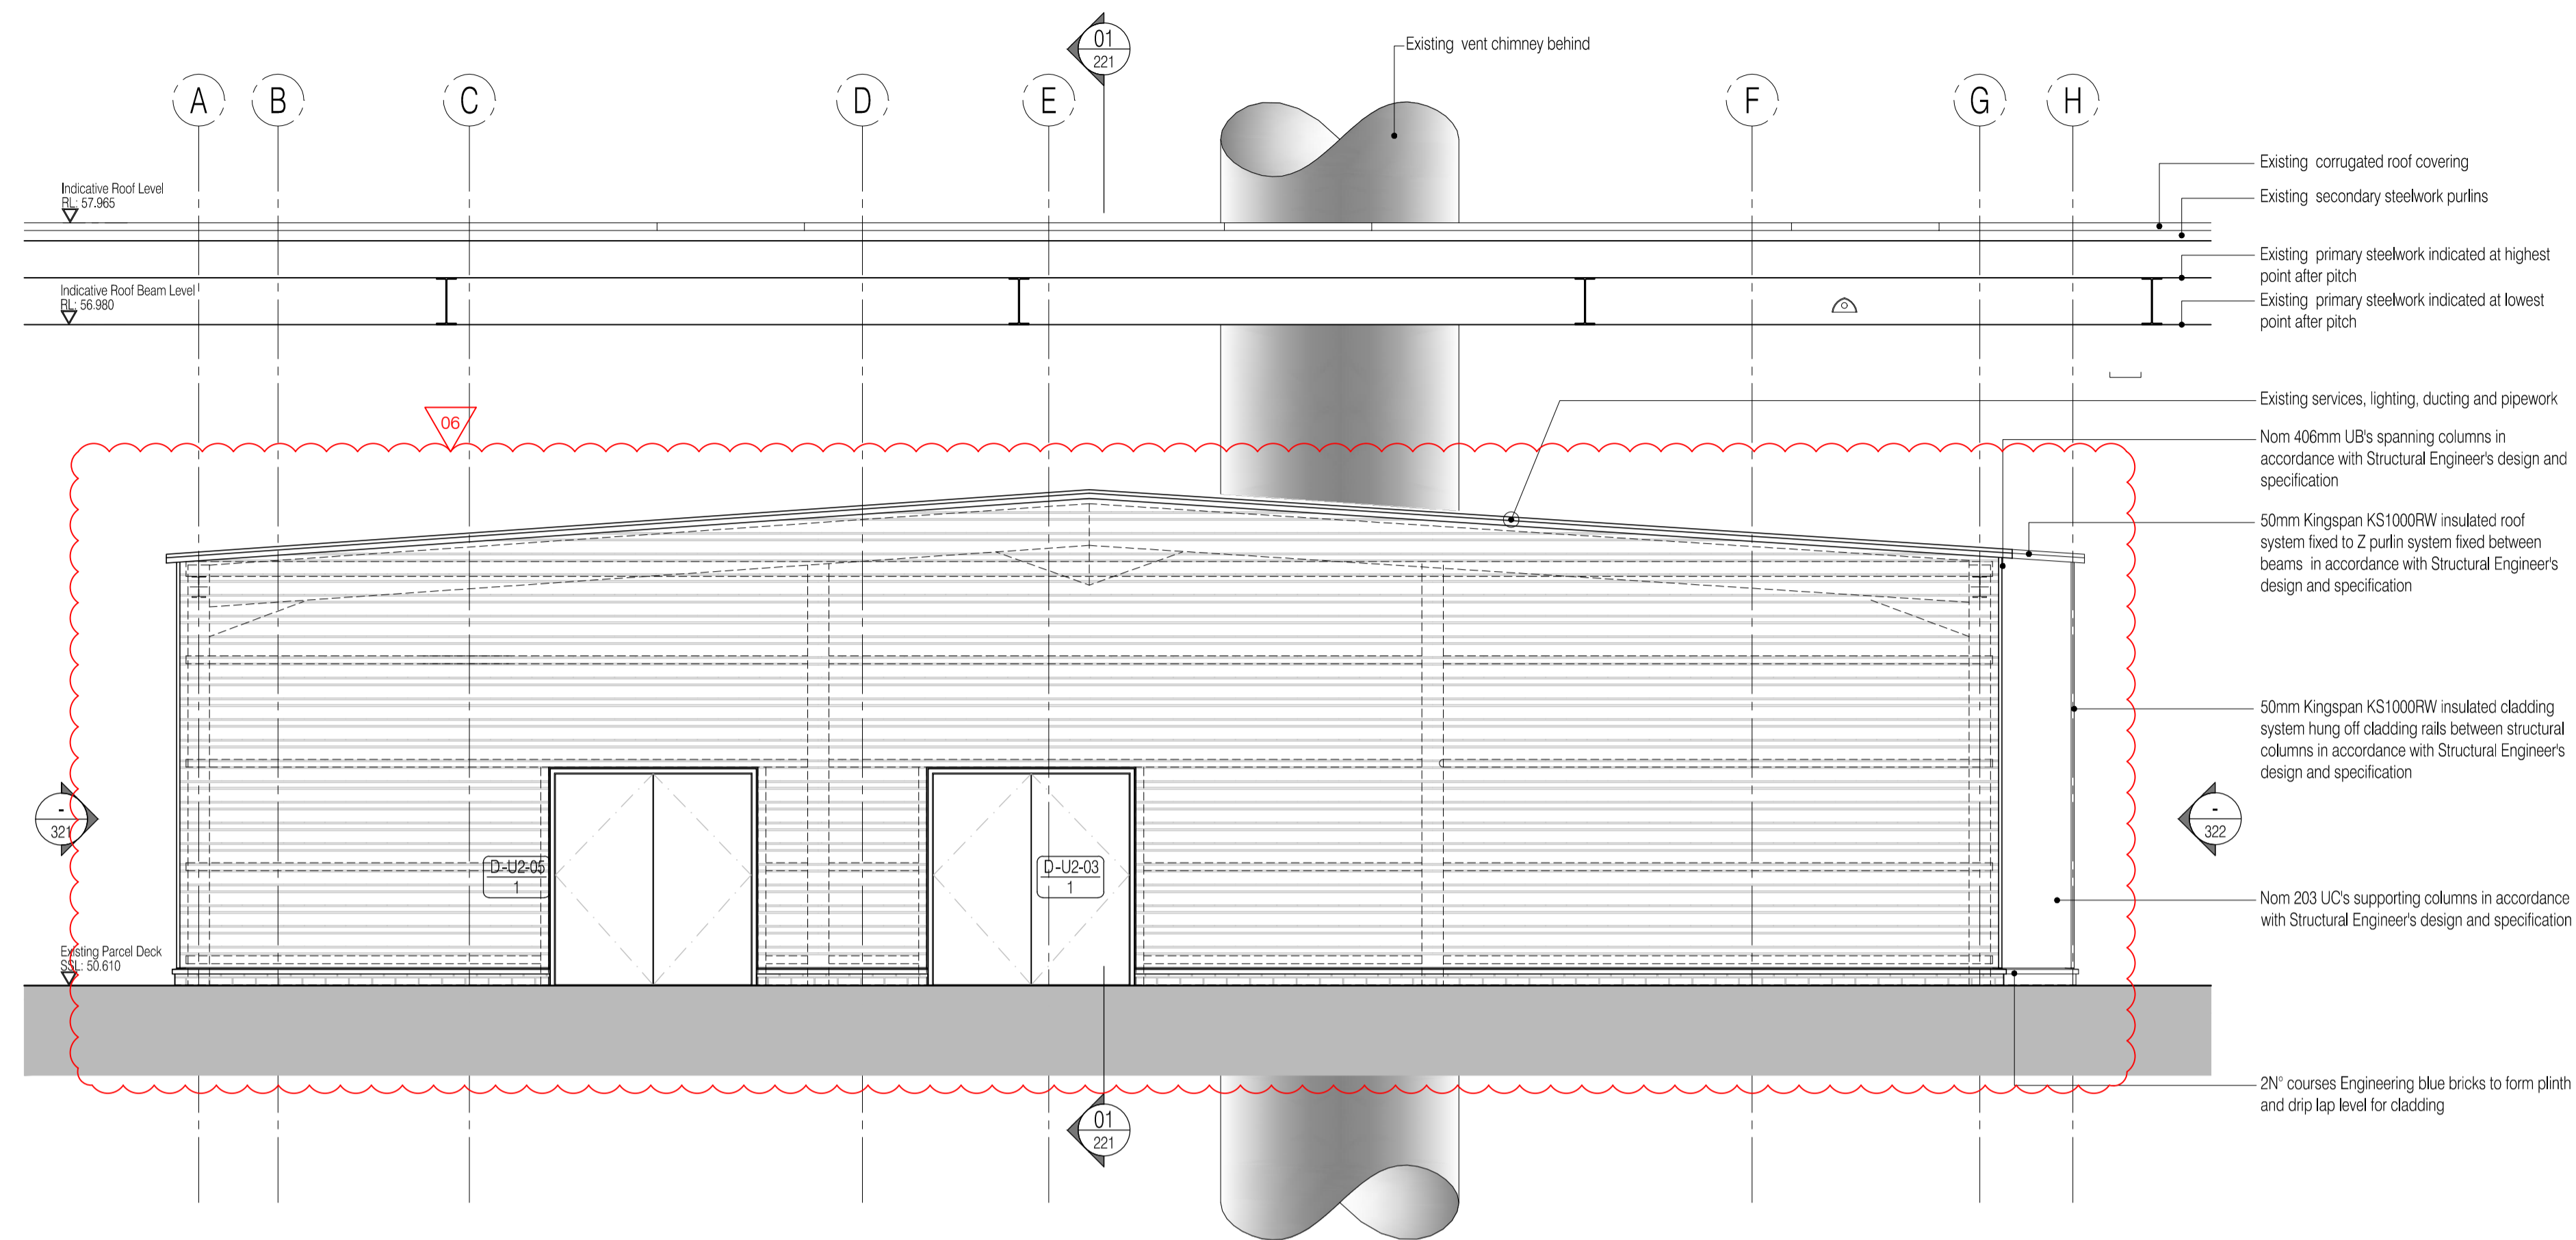

01 Unit 2 South Elevation
Scale: 1:50

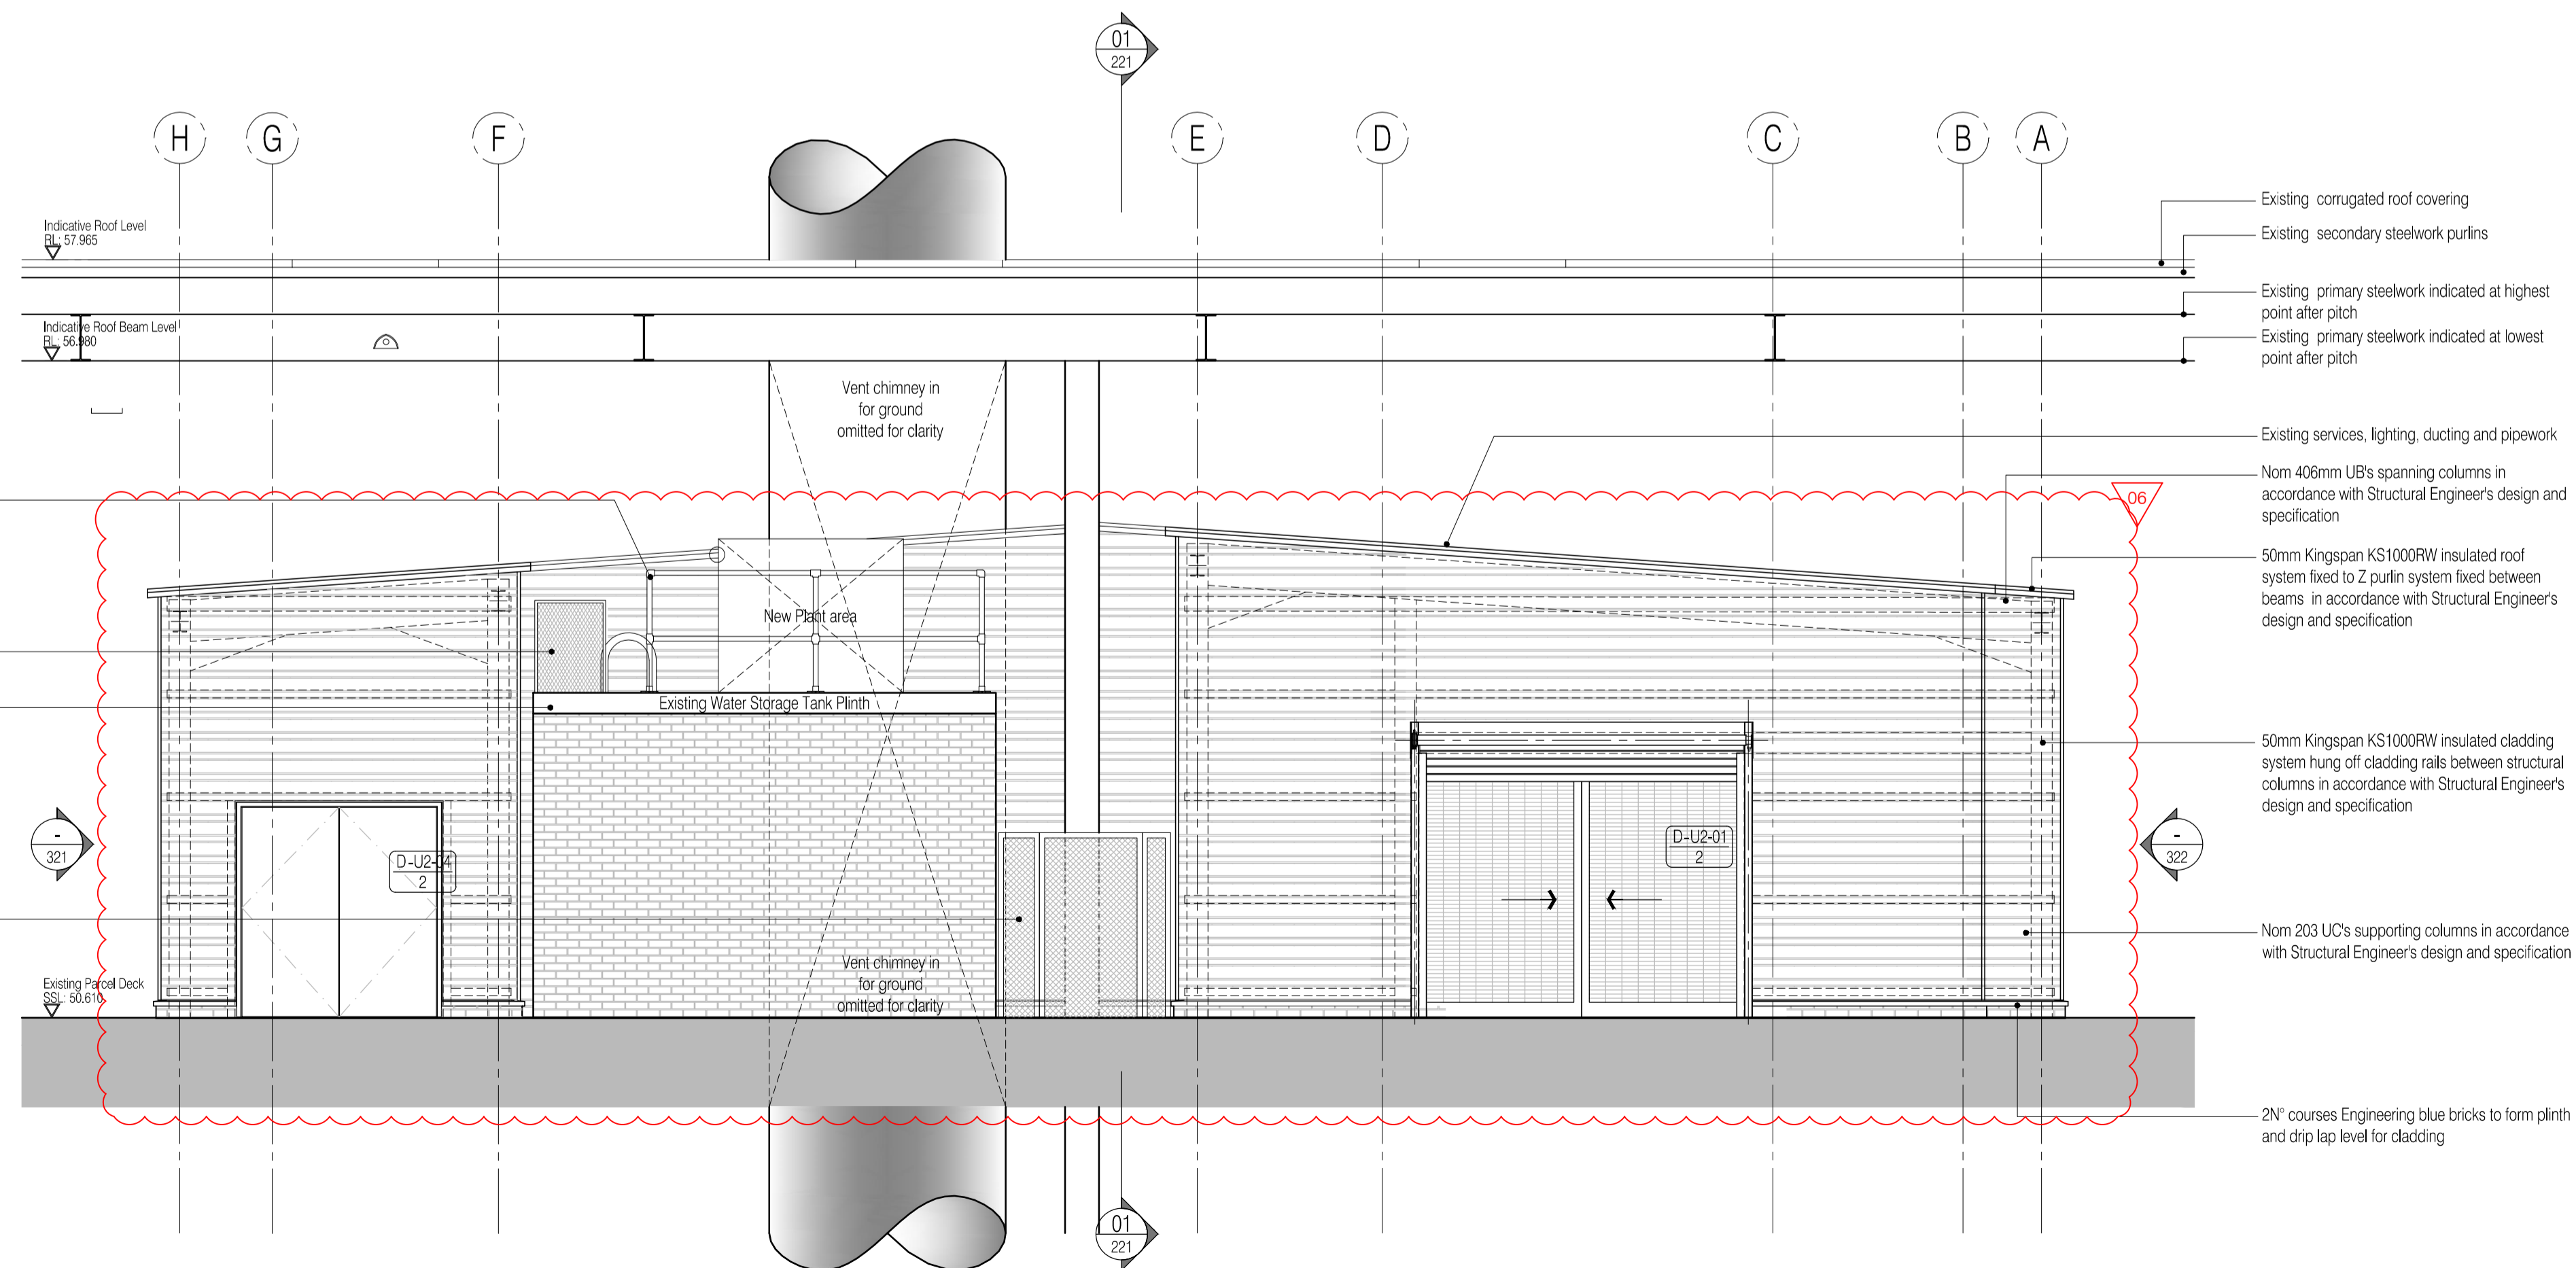

Scale: 1:50

CONSTRUCTION ISSUE

Rev	Date	By	Clk	Comment
06	28.02.11	RKC	JAS	Revised to suit structural redesign
05	22.11.10	JAS	AC	Issued for Construction
04	19.11.10	JAS	AC	Elevation updated as layout amendments
03	08.10.10	RKC	JAS	Issued for Tender
02	05.10.10	RKC	JAS	General revisions
01	29.09.10	RKC	JAS	North elevation cut-back. Issued for approval

BRINGING IDEAS TO LIFE



FRANKHAM

Frankham Consultancy Group Limited
21 Perrymount Road
Haywards Heath RH16 3TP
t 01444 444000 f 01444 455642
enquire@frankham.com
www.frankham.com

Client

Project Title

Euston Station
Parcel Deck
Rail Gourmet Facility

Drawing Title

General Arrangements
North & South Elevations
Unit 2

Drawn by: RKC	Scale: 1:50@A1	Date: 23.09.10
Designed by: FCG	Checked by: JAS	Approved by: AC

File Ref.: 444000-0020 - EUSTON PARCEL DECK ARCHITECTURE (REV 06) 13/11/09 15:13:55

Drawing No. 440272-A-320	Rev. 06
-----------------------------	------------