



NOTES: Do not scale this drawing. All dimensions to be checked on site prior to commencement or manufacture.


Key Plan (nts)

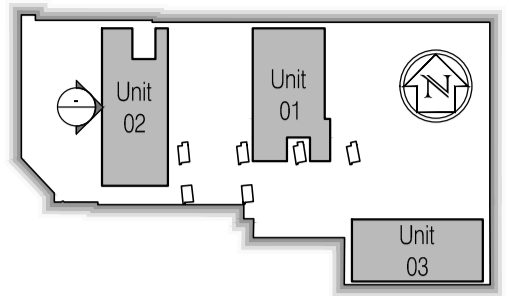

All existing building fabric, services, structural steelwork, etc. shown indicative only acquired from McDL Surveys Ltd information

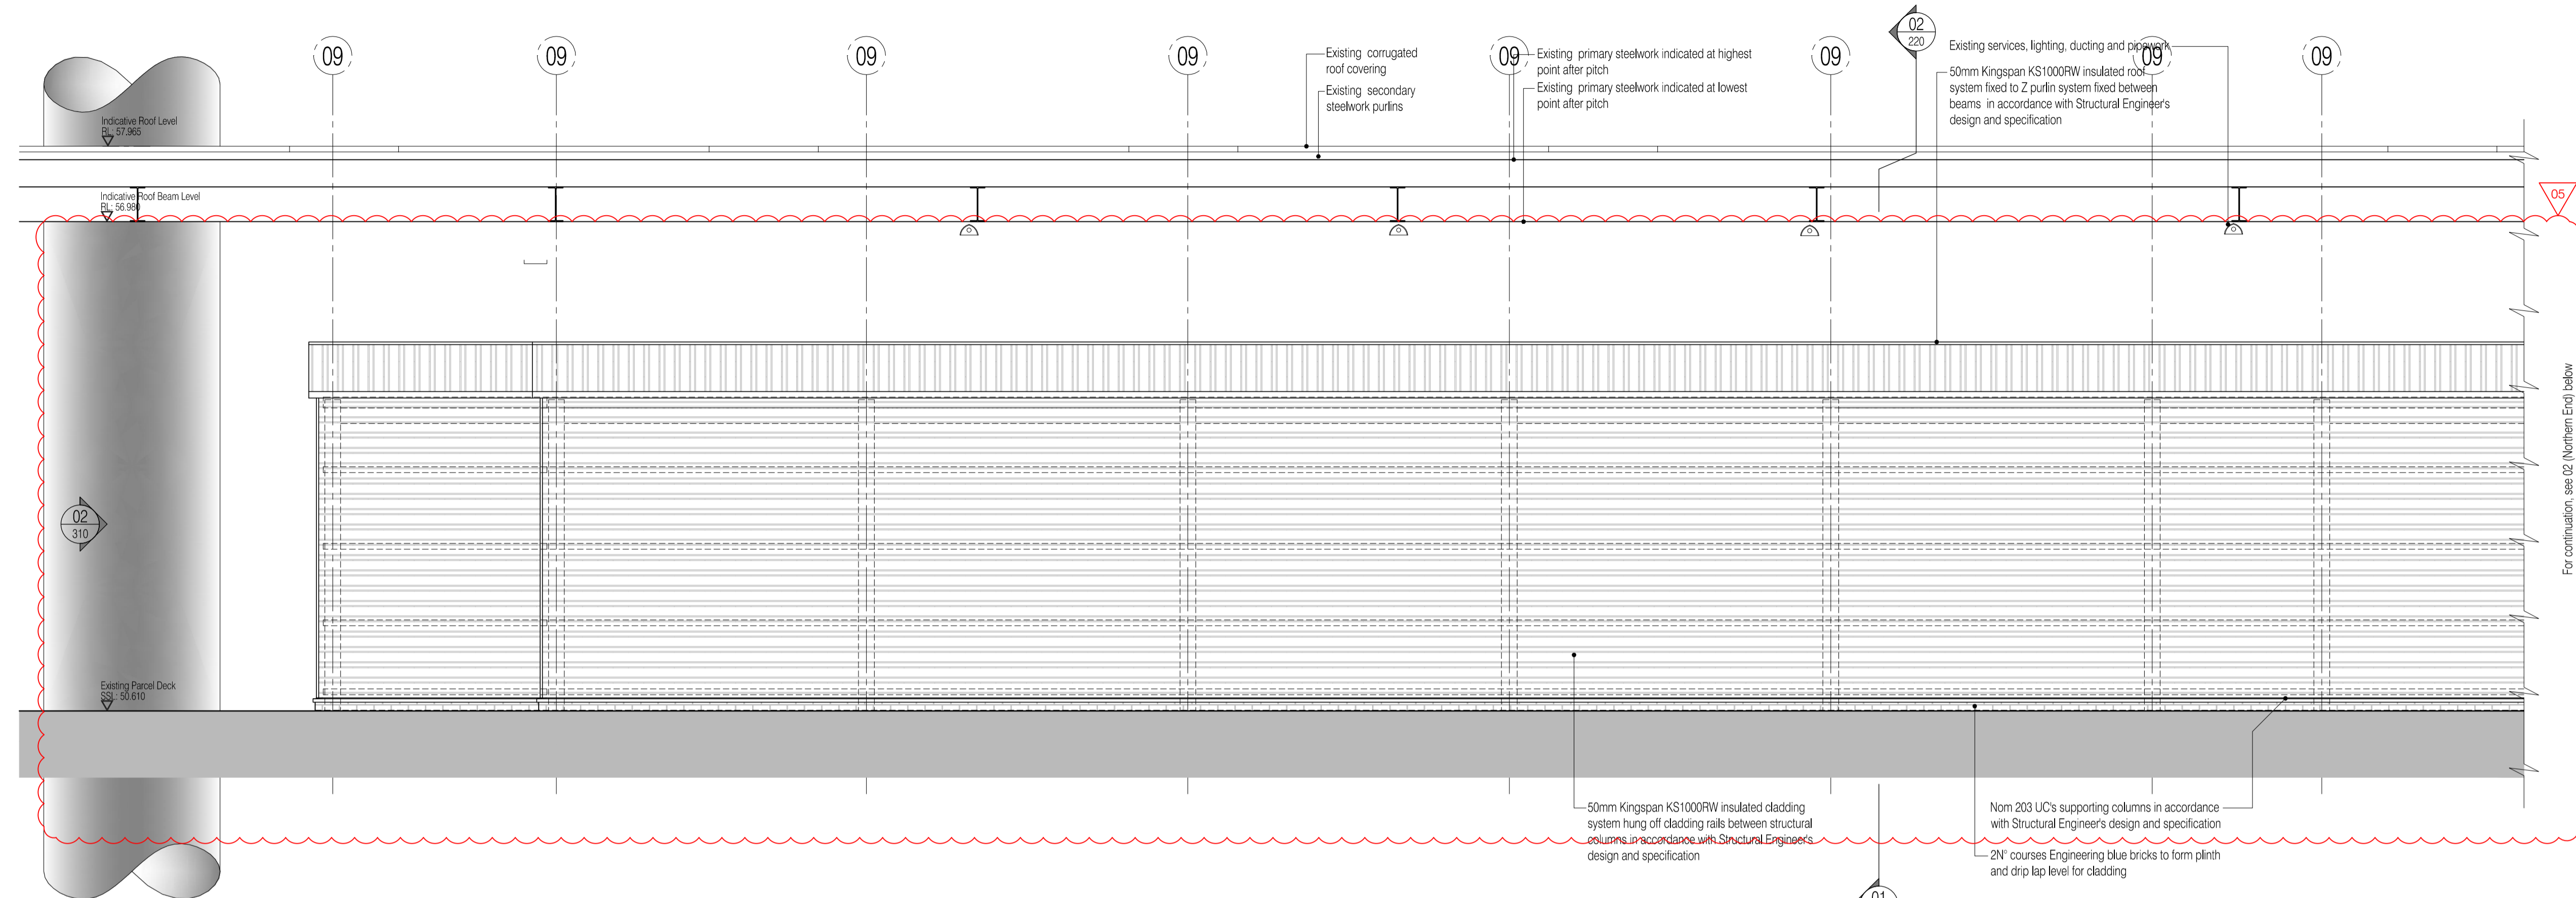

01 East Elevation (North End)
Scale: 1:50

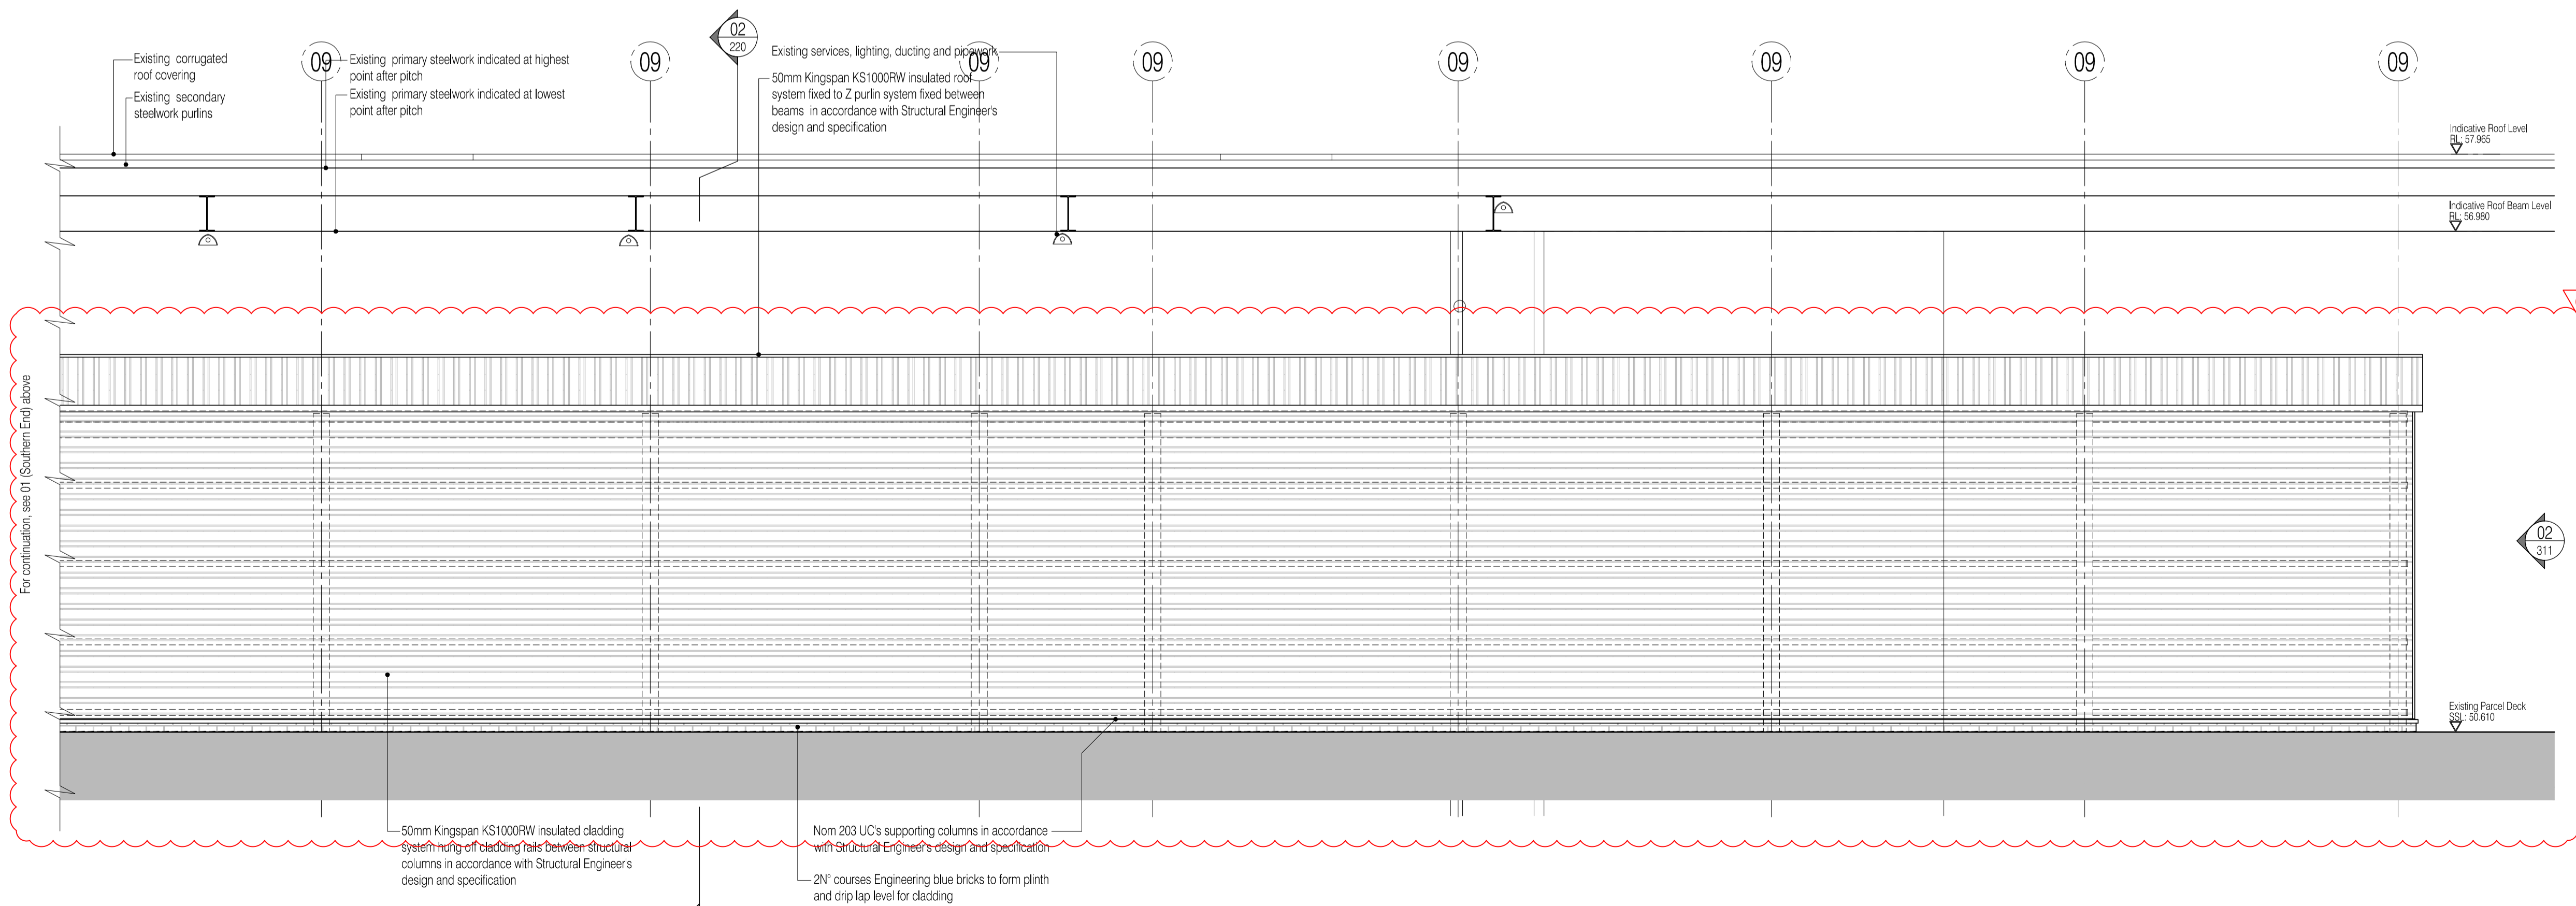

02 East Elevation (South End)
Scale: 1:50

CONSTRUCTION ISSUE

Rev	Date	By	CHK	Comment
05	28.02.11	RKC	JAS	Revised to suit structural redesign
04	22.11.10	JAS	AC	Issued for Construction
03	08.10.10	RKC	JAS	Issued for Tender
02	05.10.10	RKC	JAS	General revisions
01	29.09.10	RKC	JAS	Refs added. Issued for approval.

BRINGING IDEAS TO LIFE



FRANKHAM

Frankham Consultancy Group Limited
21 Perryman Road
Haywards Heath, RH16 3TP
t 01444 444000 f 01444 455642
enquire@frankham.com
www.frankham.com

Client

Project Title

Euston Station
Parcel Deck
Rail Gourmet Facility

Drawing Title

General Arrangements
East Elevations
Unit 2

Drawn by: RKC	Scale: 1:50@A1	Date: 23.09.10
Designed by: FCG	Checked by: JAS	Approved by: AC

File Ref.: X:\440272-A-321\440272-A-321\440272-A-321\440272-A-321.dwg 13/11/09 15:12:45

Drawing No. 440272-A-321	Rev. 05
-----------------------------	------------