



NOTES: Do not scale this drawing. All dimensions to be checked on site prior to commencement or manufacture.


Key Plan (nts)

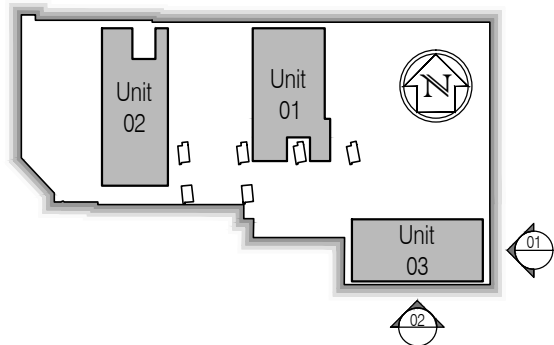

All existing building fabric, services, structural steelwork, etc. shown indicative only acquired from McDL Surveys Ltd information

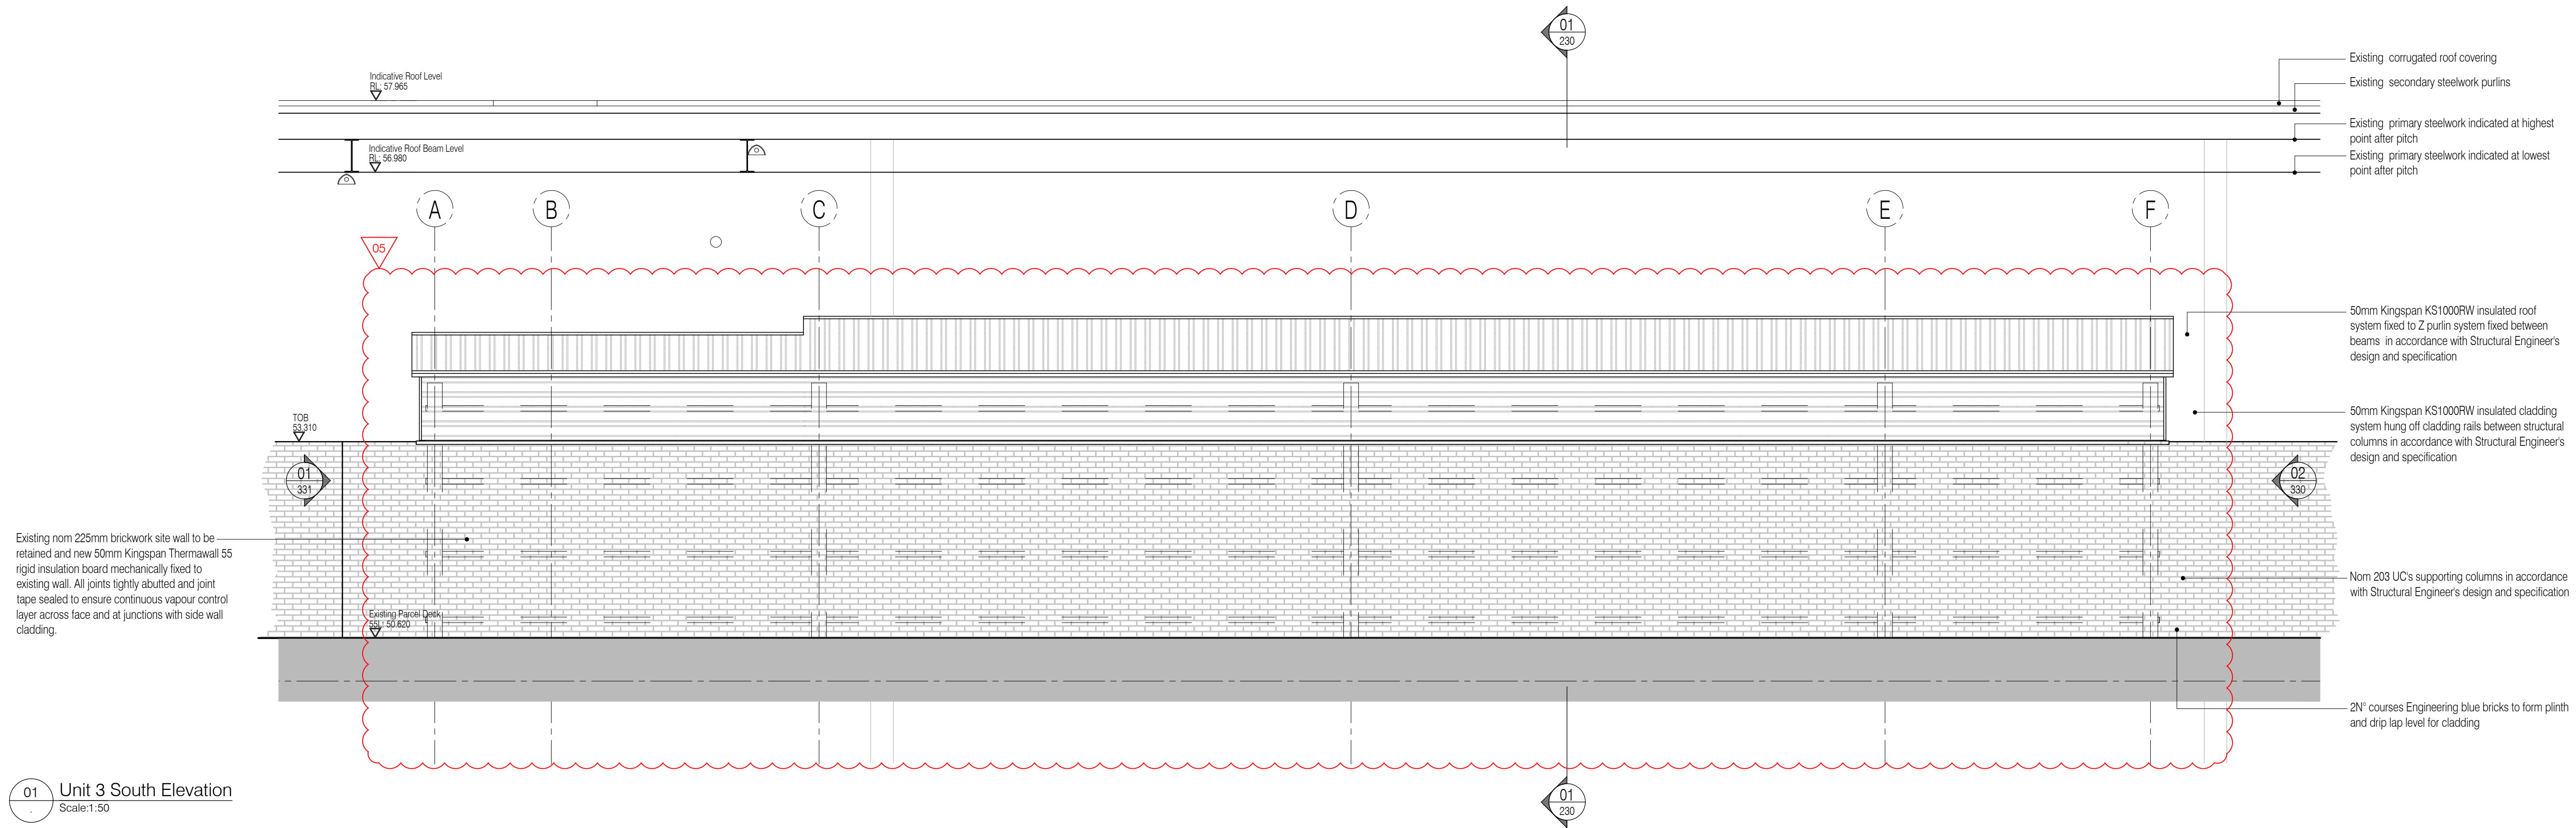

01 Unit 3 South Elevation
Scale: 1:50

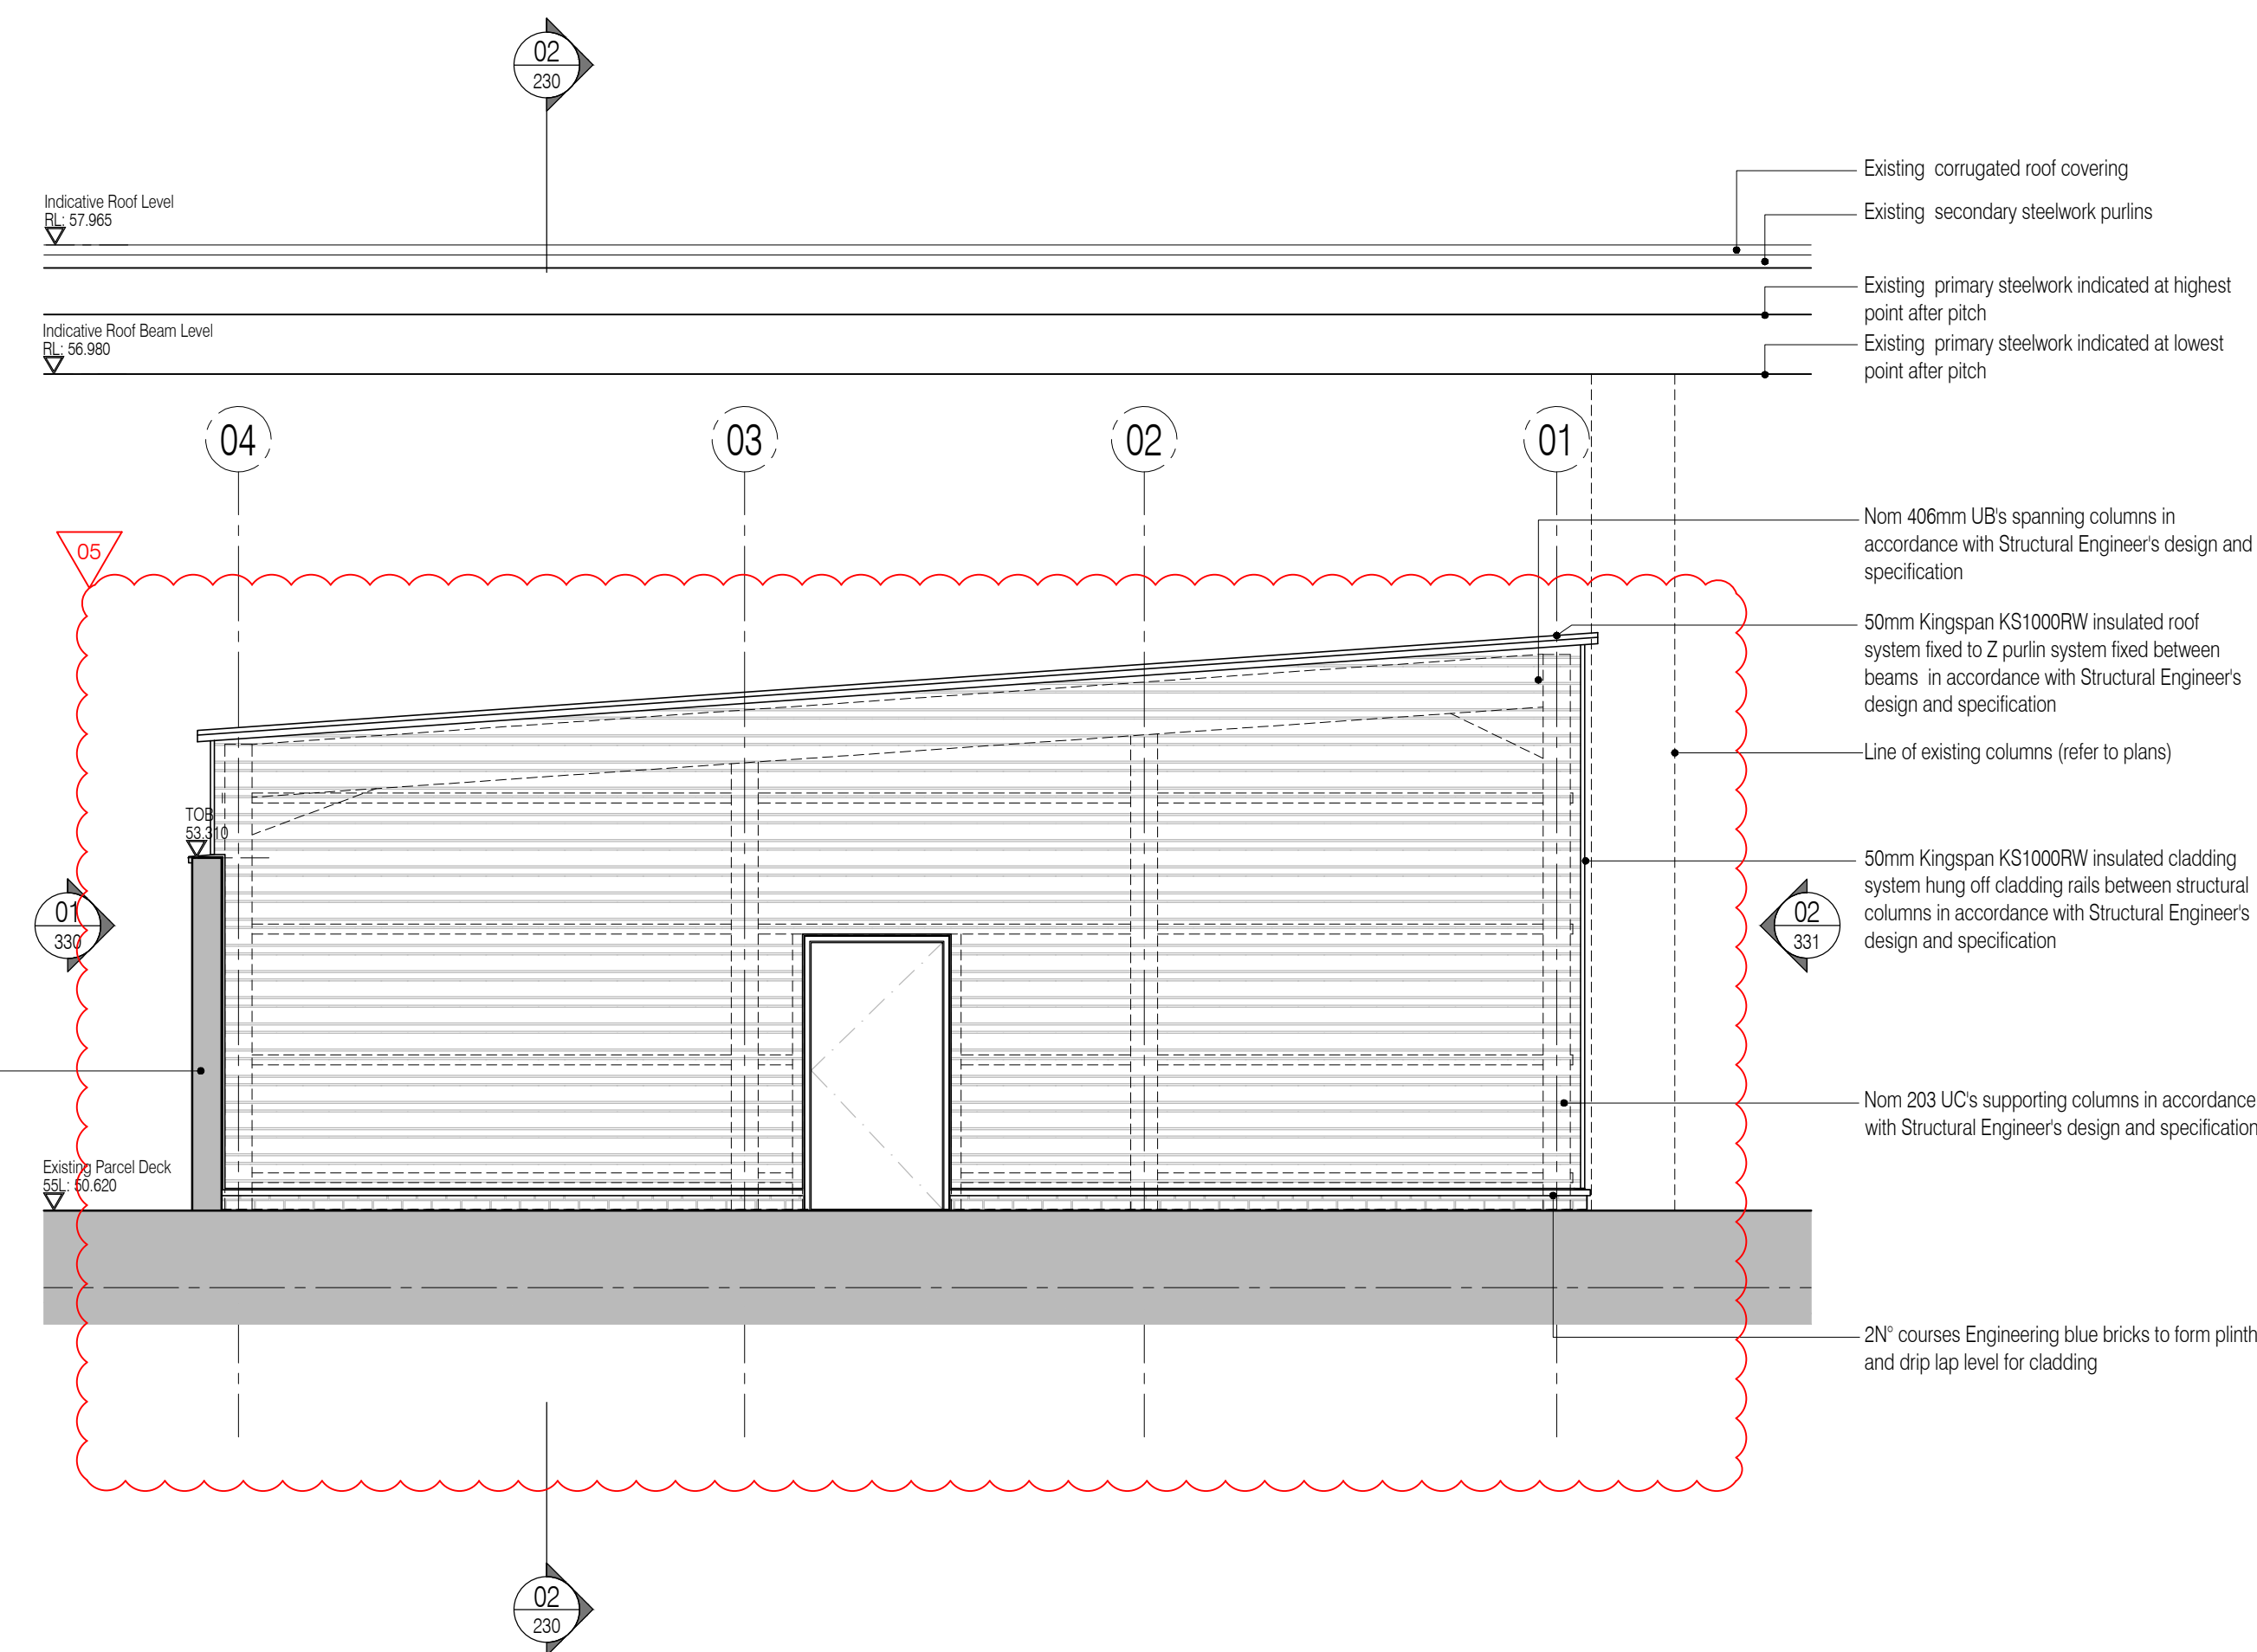

02 Unit 3 East Elevation
Scale: 1:50

CONSTRUCTION ISSUE

Rev	Date	By	CHK	Comment
05	01.03.11	RKC	JAS	Revised to suit structural redesign
04	22.11.10	JAS	AC	Issued for Construction
03	08.10.10	RKC	JAS	Issued for Tender
02	05.10.10	RKC	JAS	General revisions
01	29.09.10	RKC	JAS	Refs added. Issued for approval.

BRINGING IDEAS TO LIFE

FRANKHAM

Frankham Consultancy Group Limited
 21 Perrymount Road
 Hayward Heath RH16 3TP
 t 01444 444900 f 01444 455642
 enquiry@frankham.com
 www.frankham.com

Client

Project Title

Euston Station
 Parcel Deck
 Rail Gourmet Facility

Drawing Title

General Arrangements
 East & South Elevations
 Unit 3

Drawn by: RKC	Scale: 1:50@A1	Date: 23.09.10
Designed by: FCG	Checked by: JAS	Approved by: AC

File Ref.: X:\FRANKHAM\CG\440272\ESTON\ARCH\03_06_ELEVATIONS 440272-A-330-05 - 200911140272	20.06.11.14.32.28
Drawing No. 440272-A-330	Rev. 05