
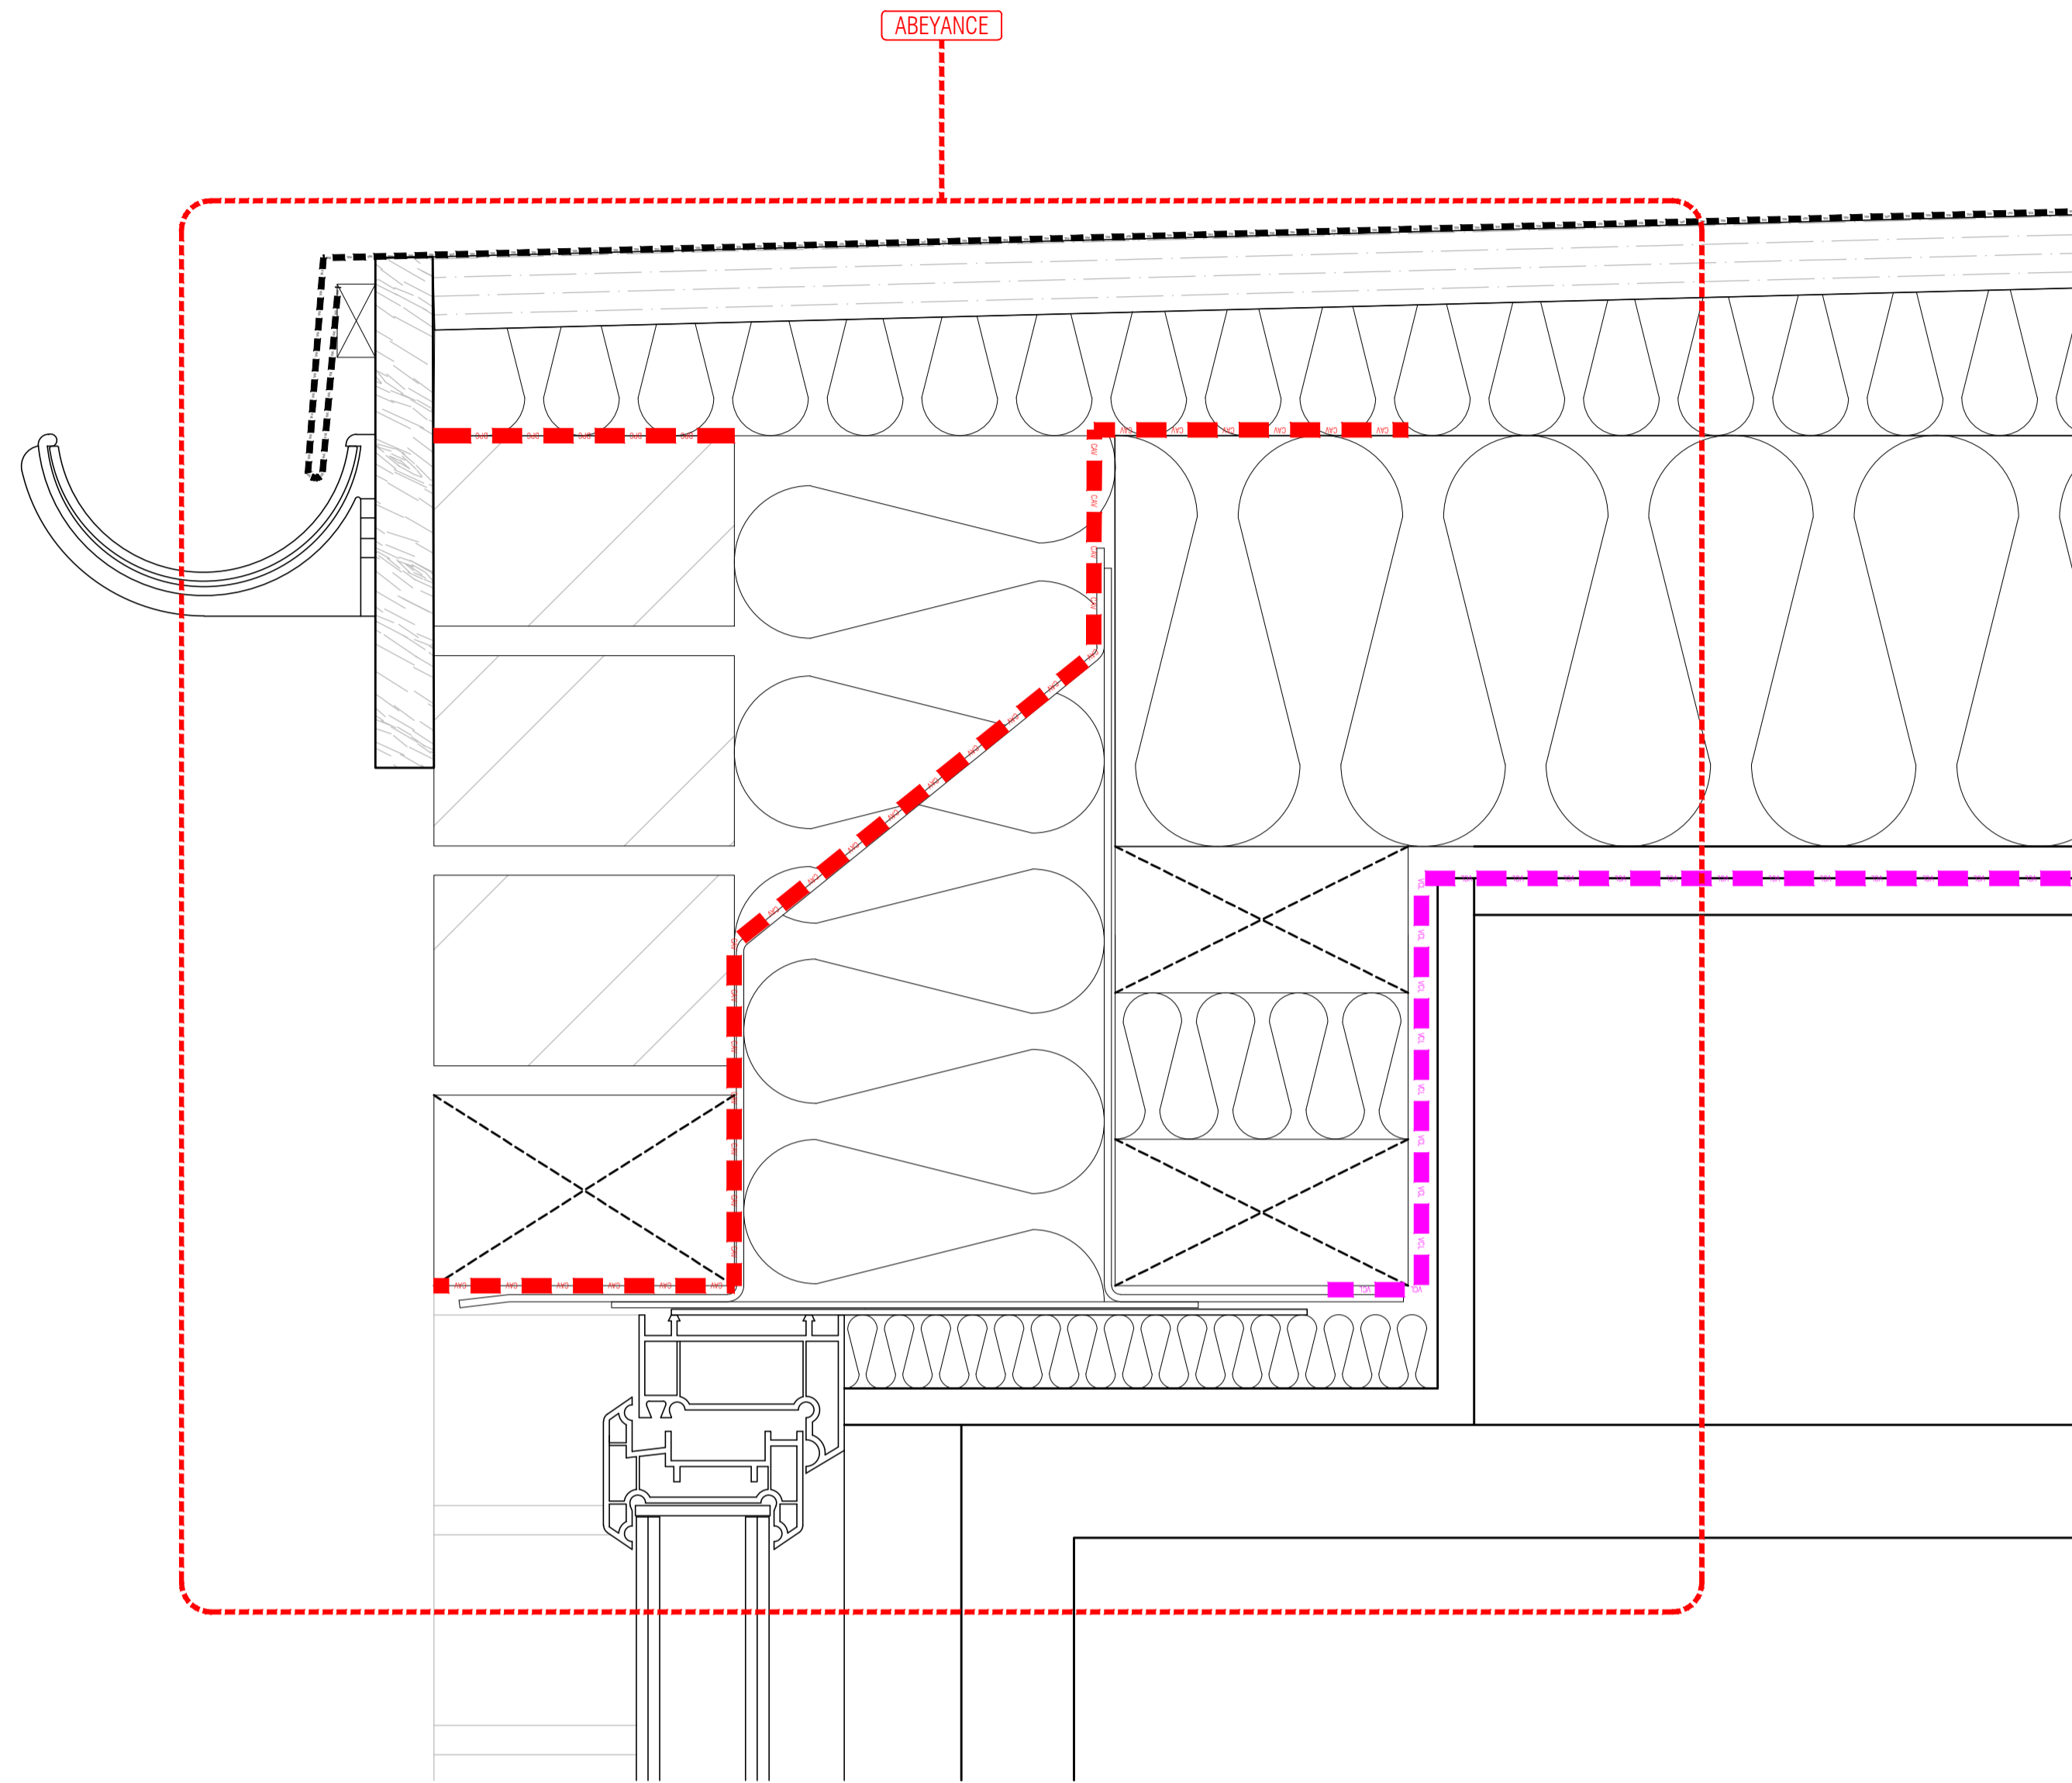
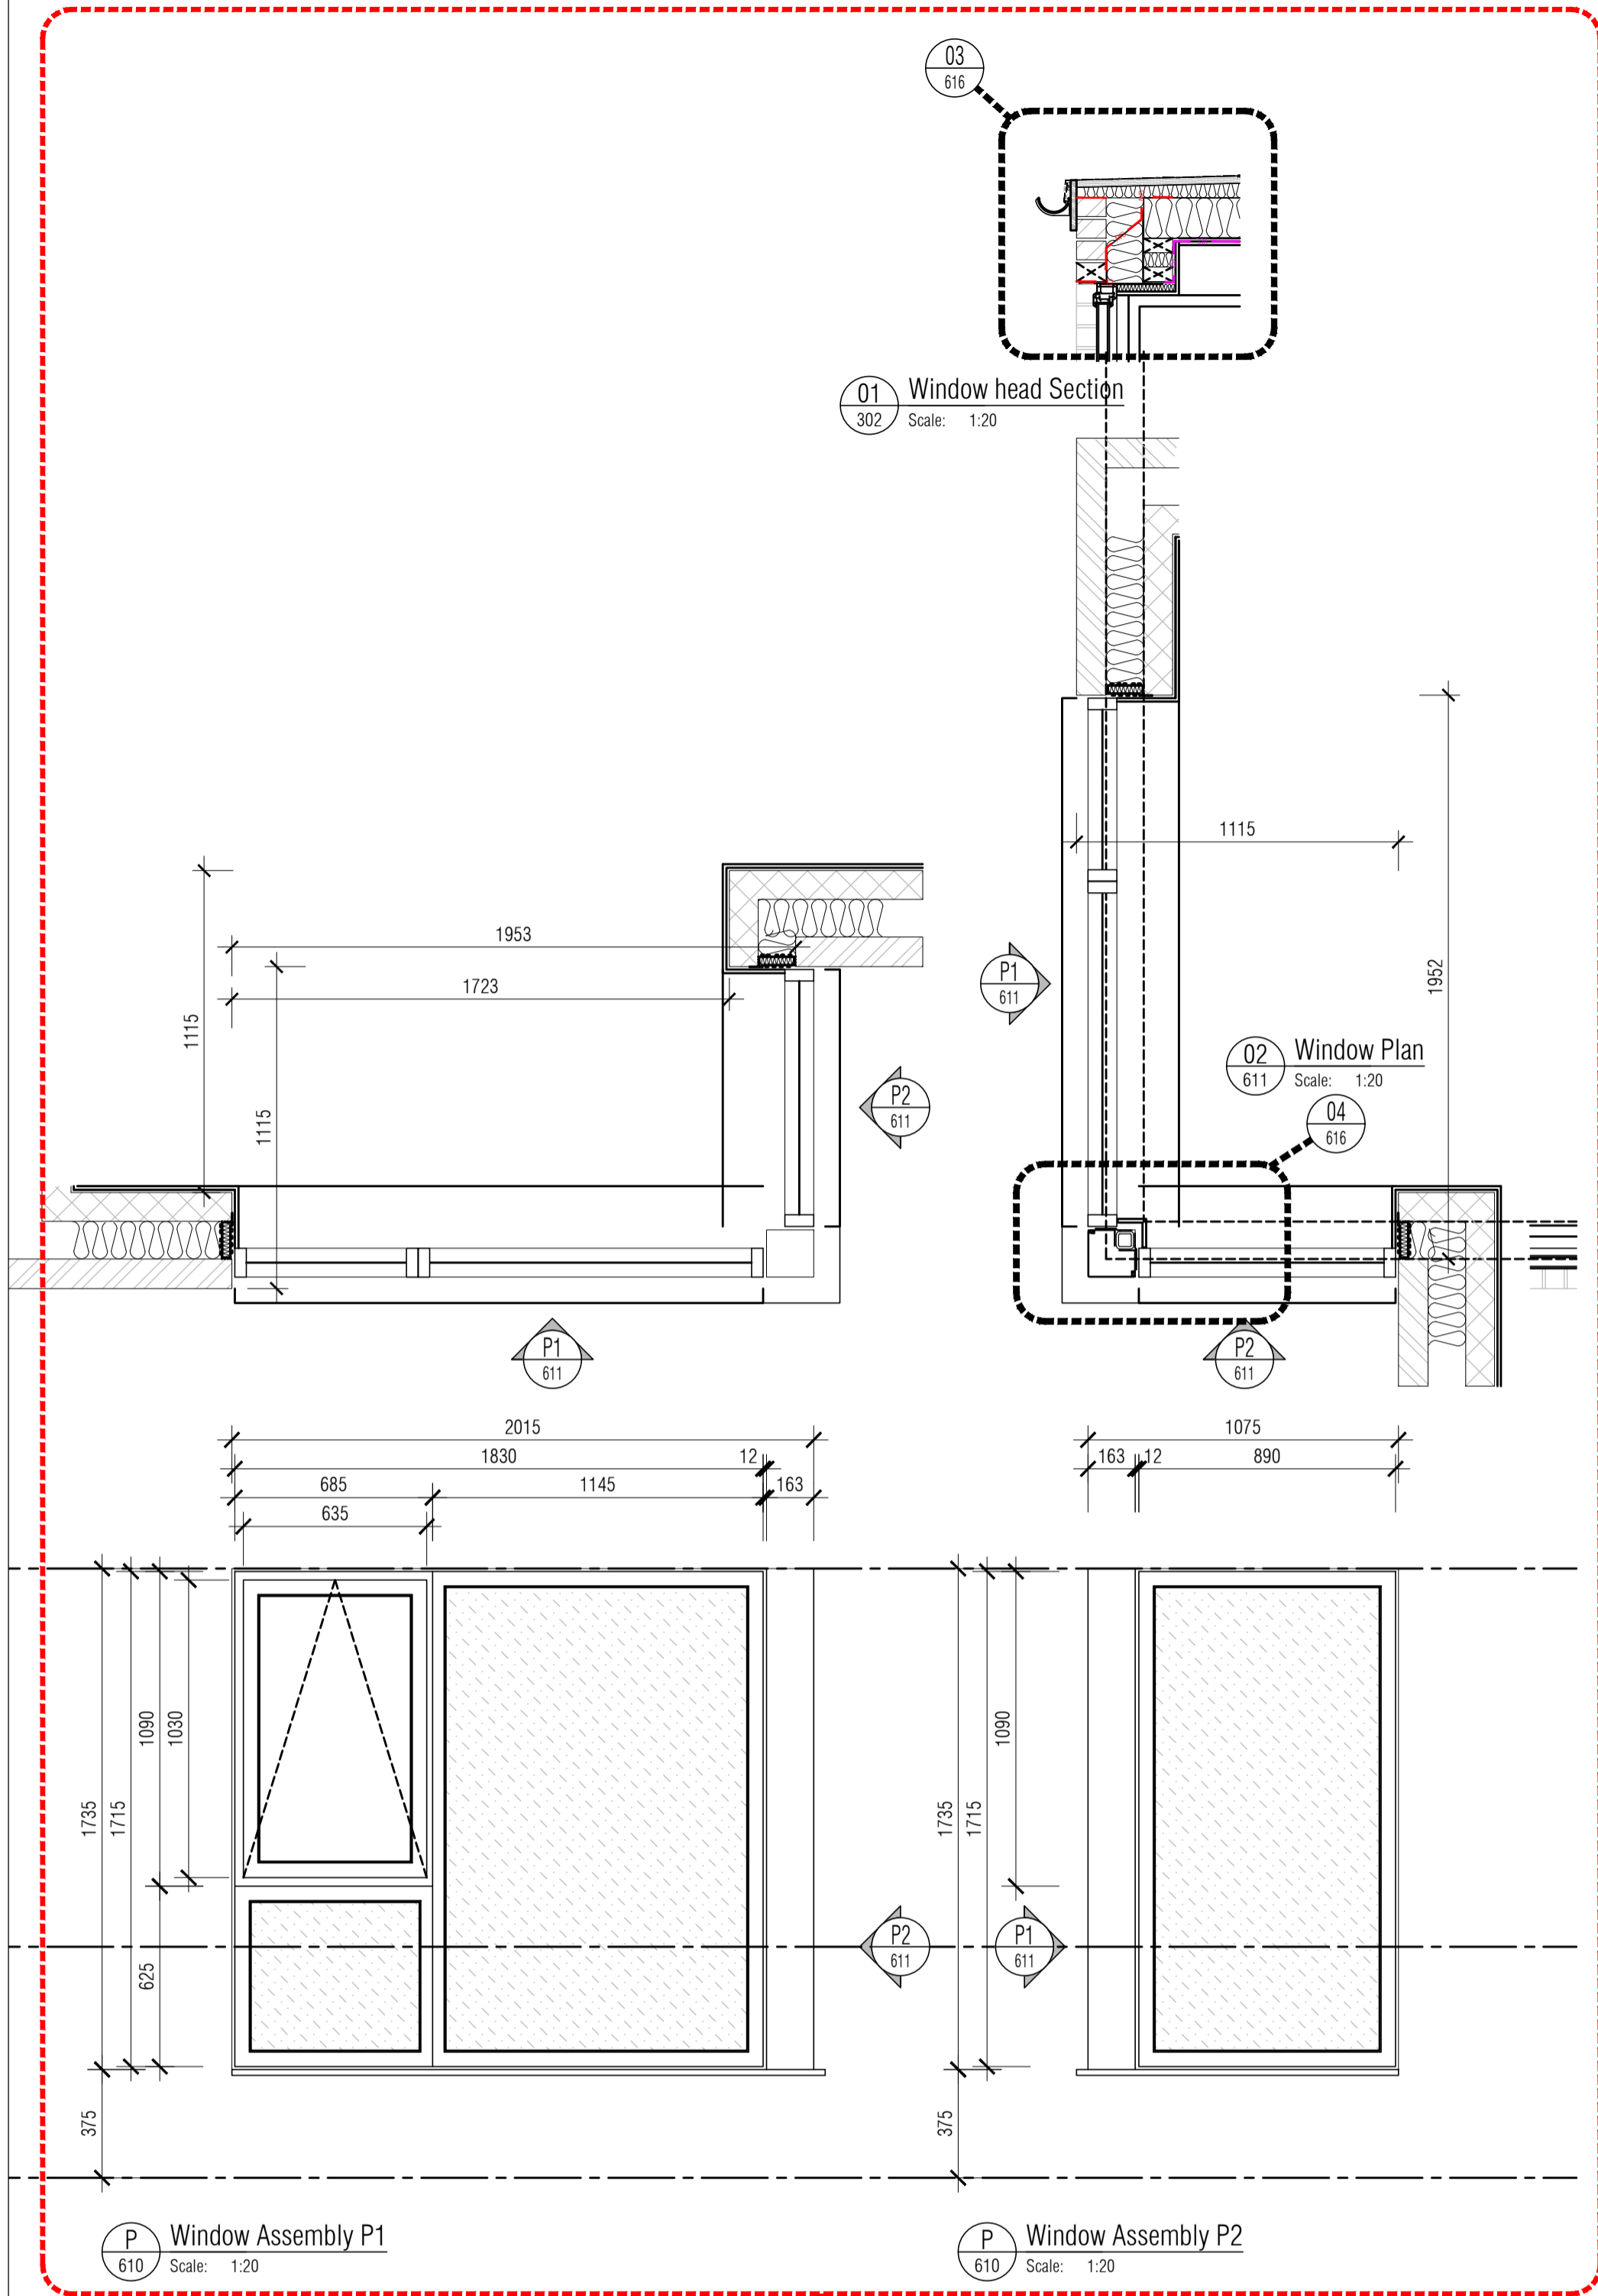



1. CONTRACTOR IS RESPONSIBLE FOR ALL SETTING OUT AND MUST CHECK DIMENSIONS ON SITE BEFORE WORK IS PUT IN HAND
2. WRITTEN DIMENSIONS ONLY TO BE TAKEN THIS DRAWING MUST NOT BE SCALED
3. ARCHITECT TO BE IMMEDIATELY NOTIFIED OF SUSPECTED OMISSIONS OR DISCREPANCIES

REVISIONS	DATE	BY
ISSUED FOR CONSTRUCTION	17.05.16	rkc

Elevations Legend
 Denotes safety glass



03 Window head Detail
Scale: 1:2

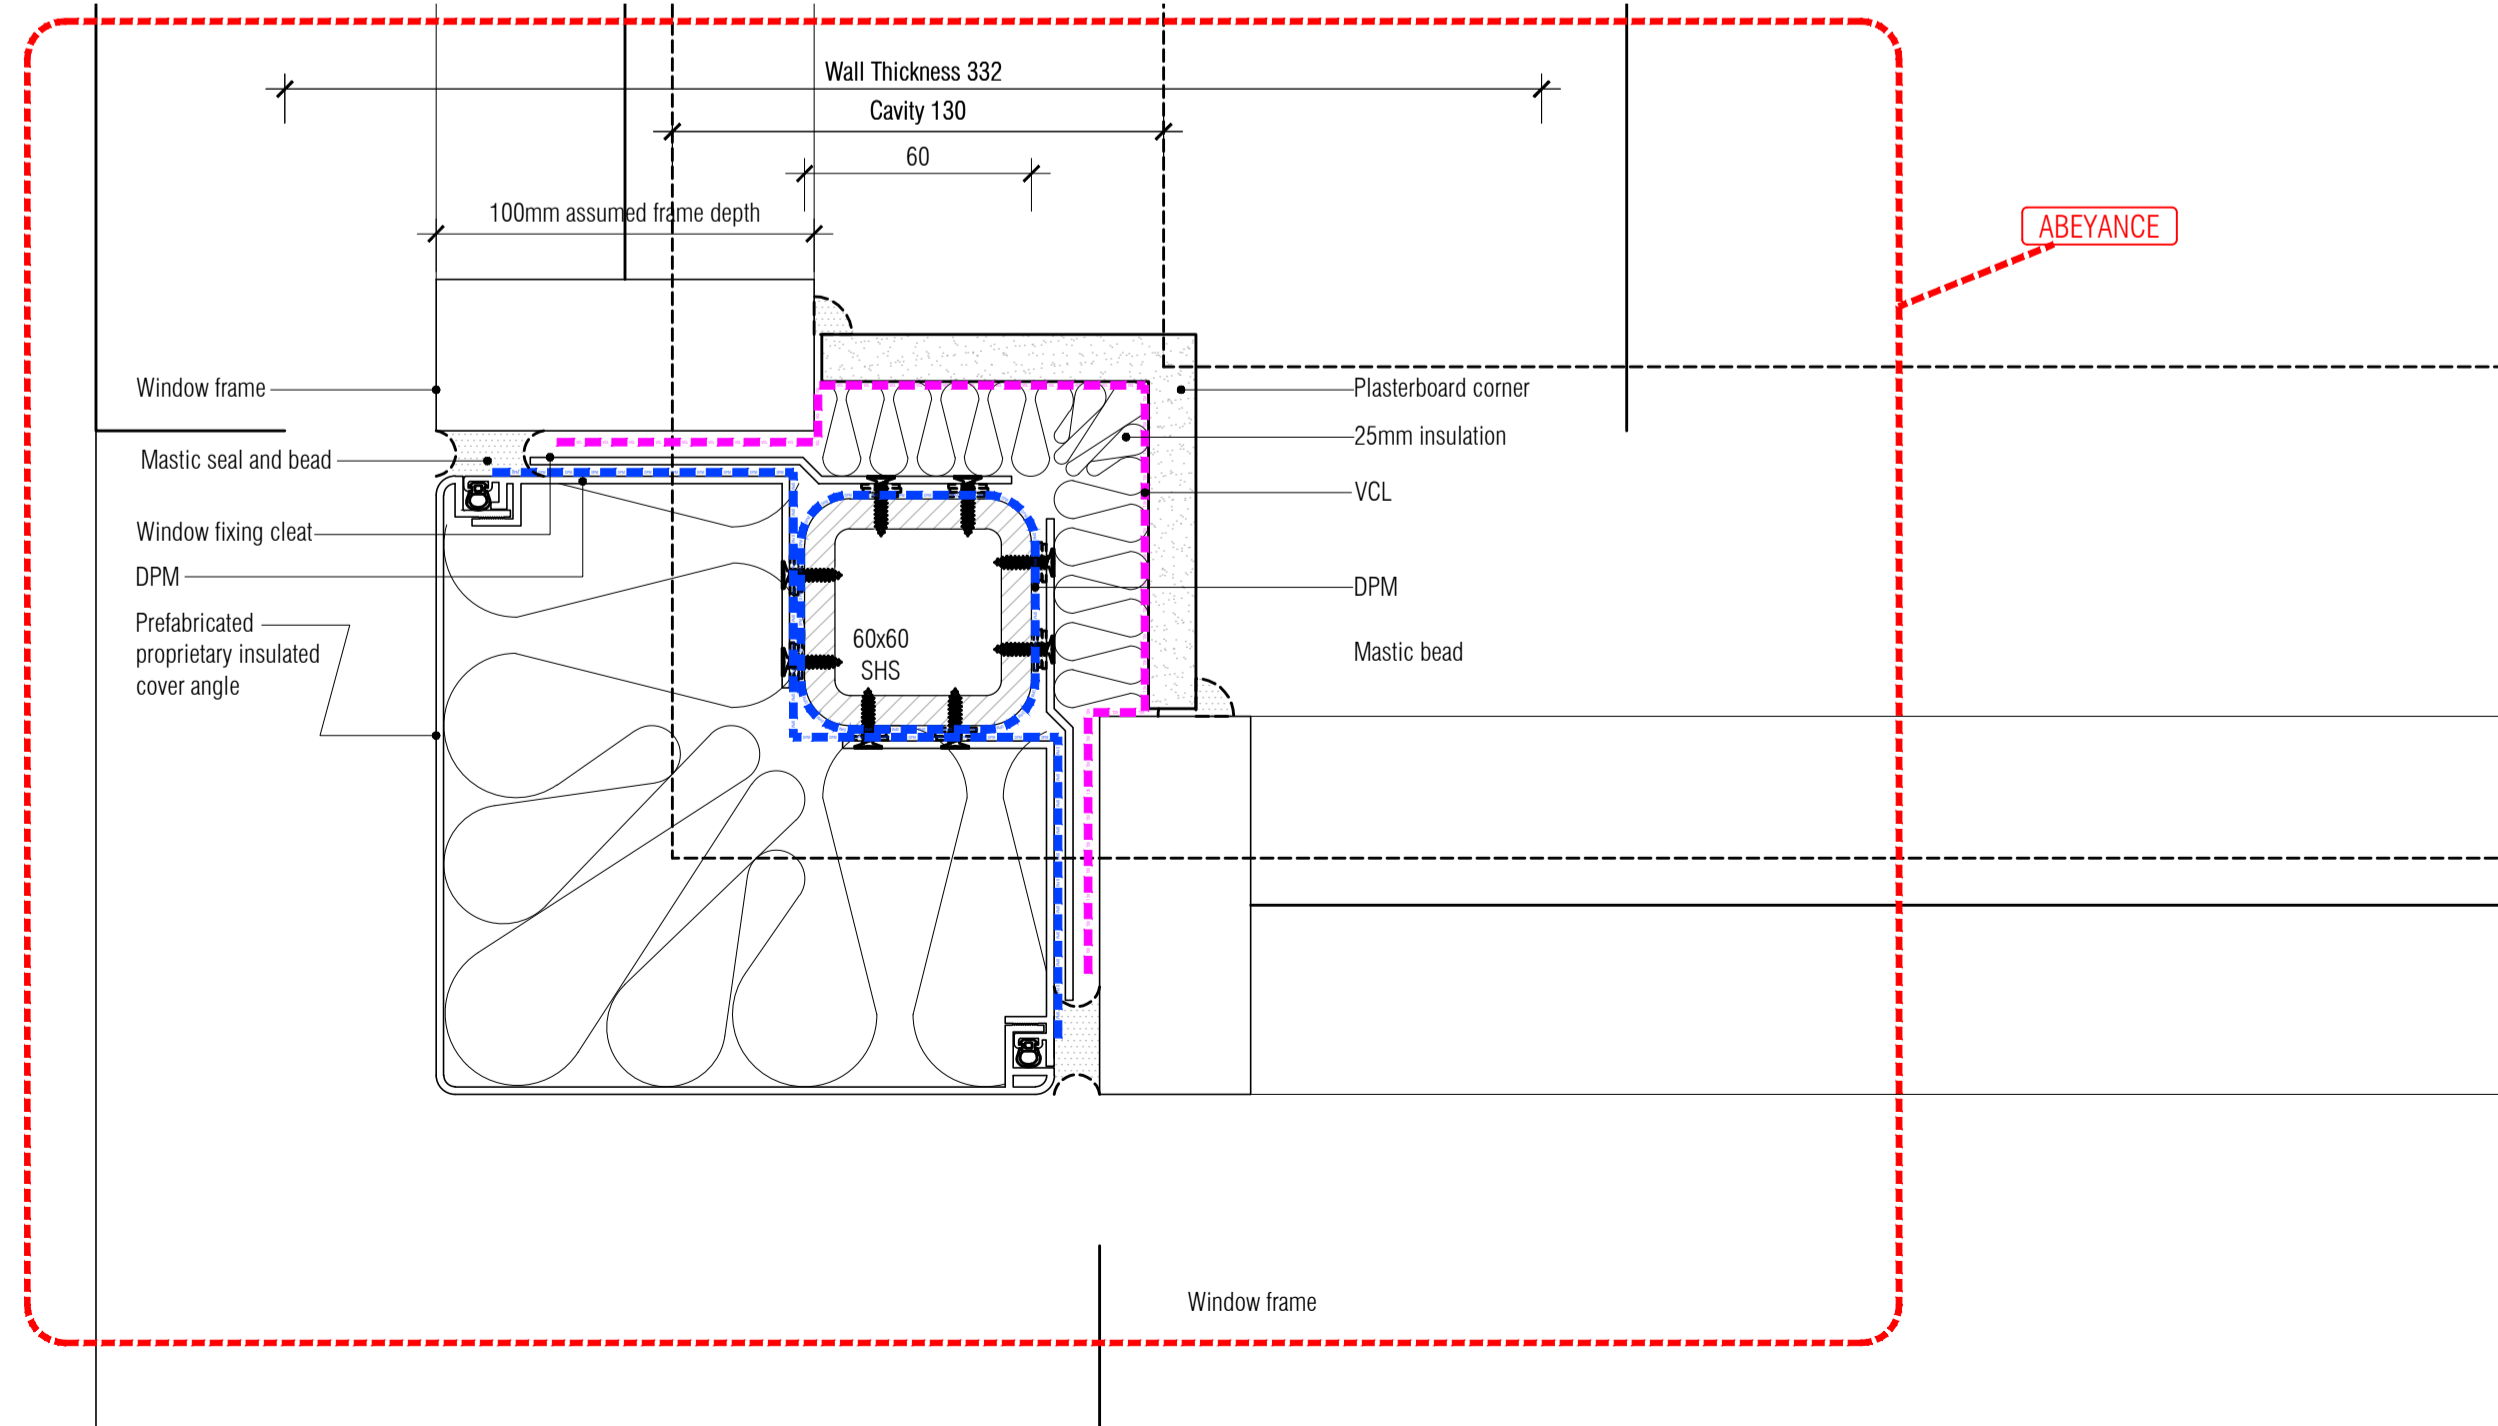

04 Window Post Detail
Scale: 1:2

NOT ISSUE FOR CONSTRUCTION

RDJW

ARCHITECTS



RDJW ARCHITECTS LIMITED
 QUIN HOUSE . 9-11 EAST PARK
 CRAWLEY . WEST SUSSEX . RH10 6AN
 TEL: 01293 404300 . FAX: 01293 404299
 EMAIL: info@rdjwarchitects.co.uk
 WEBSITE: www.rdjwarchitects.co.uk

PROJECT
 Housing Development
 Springfield Hospital
 Hebdon Road
 Tooting

Proposed
 Window Assembly Option 2
 Detail

DATE 17.12.15 SCALE 1:2, 1:20 @ A1

DRAWN RKC	DRG. NO. 4720-616	REV. C1
-----------	-------------------	---------