These drawings have been edited in accordance with Willmott Dixon's instructions. All material, product, volume, dimension and performance information is indicative only. FCG repudiate any and all liability for failure or non performance of any or the afore mentioned items as indicated on this or any other FCG documentation.

NOTES: Do not scale this drawing. All dimensions to be checked on site prior to commencement or manufacture.

Key Plan
1:1000

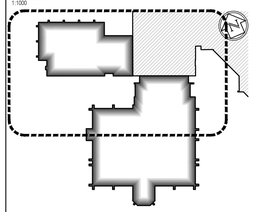

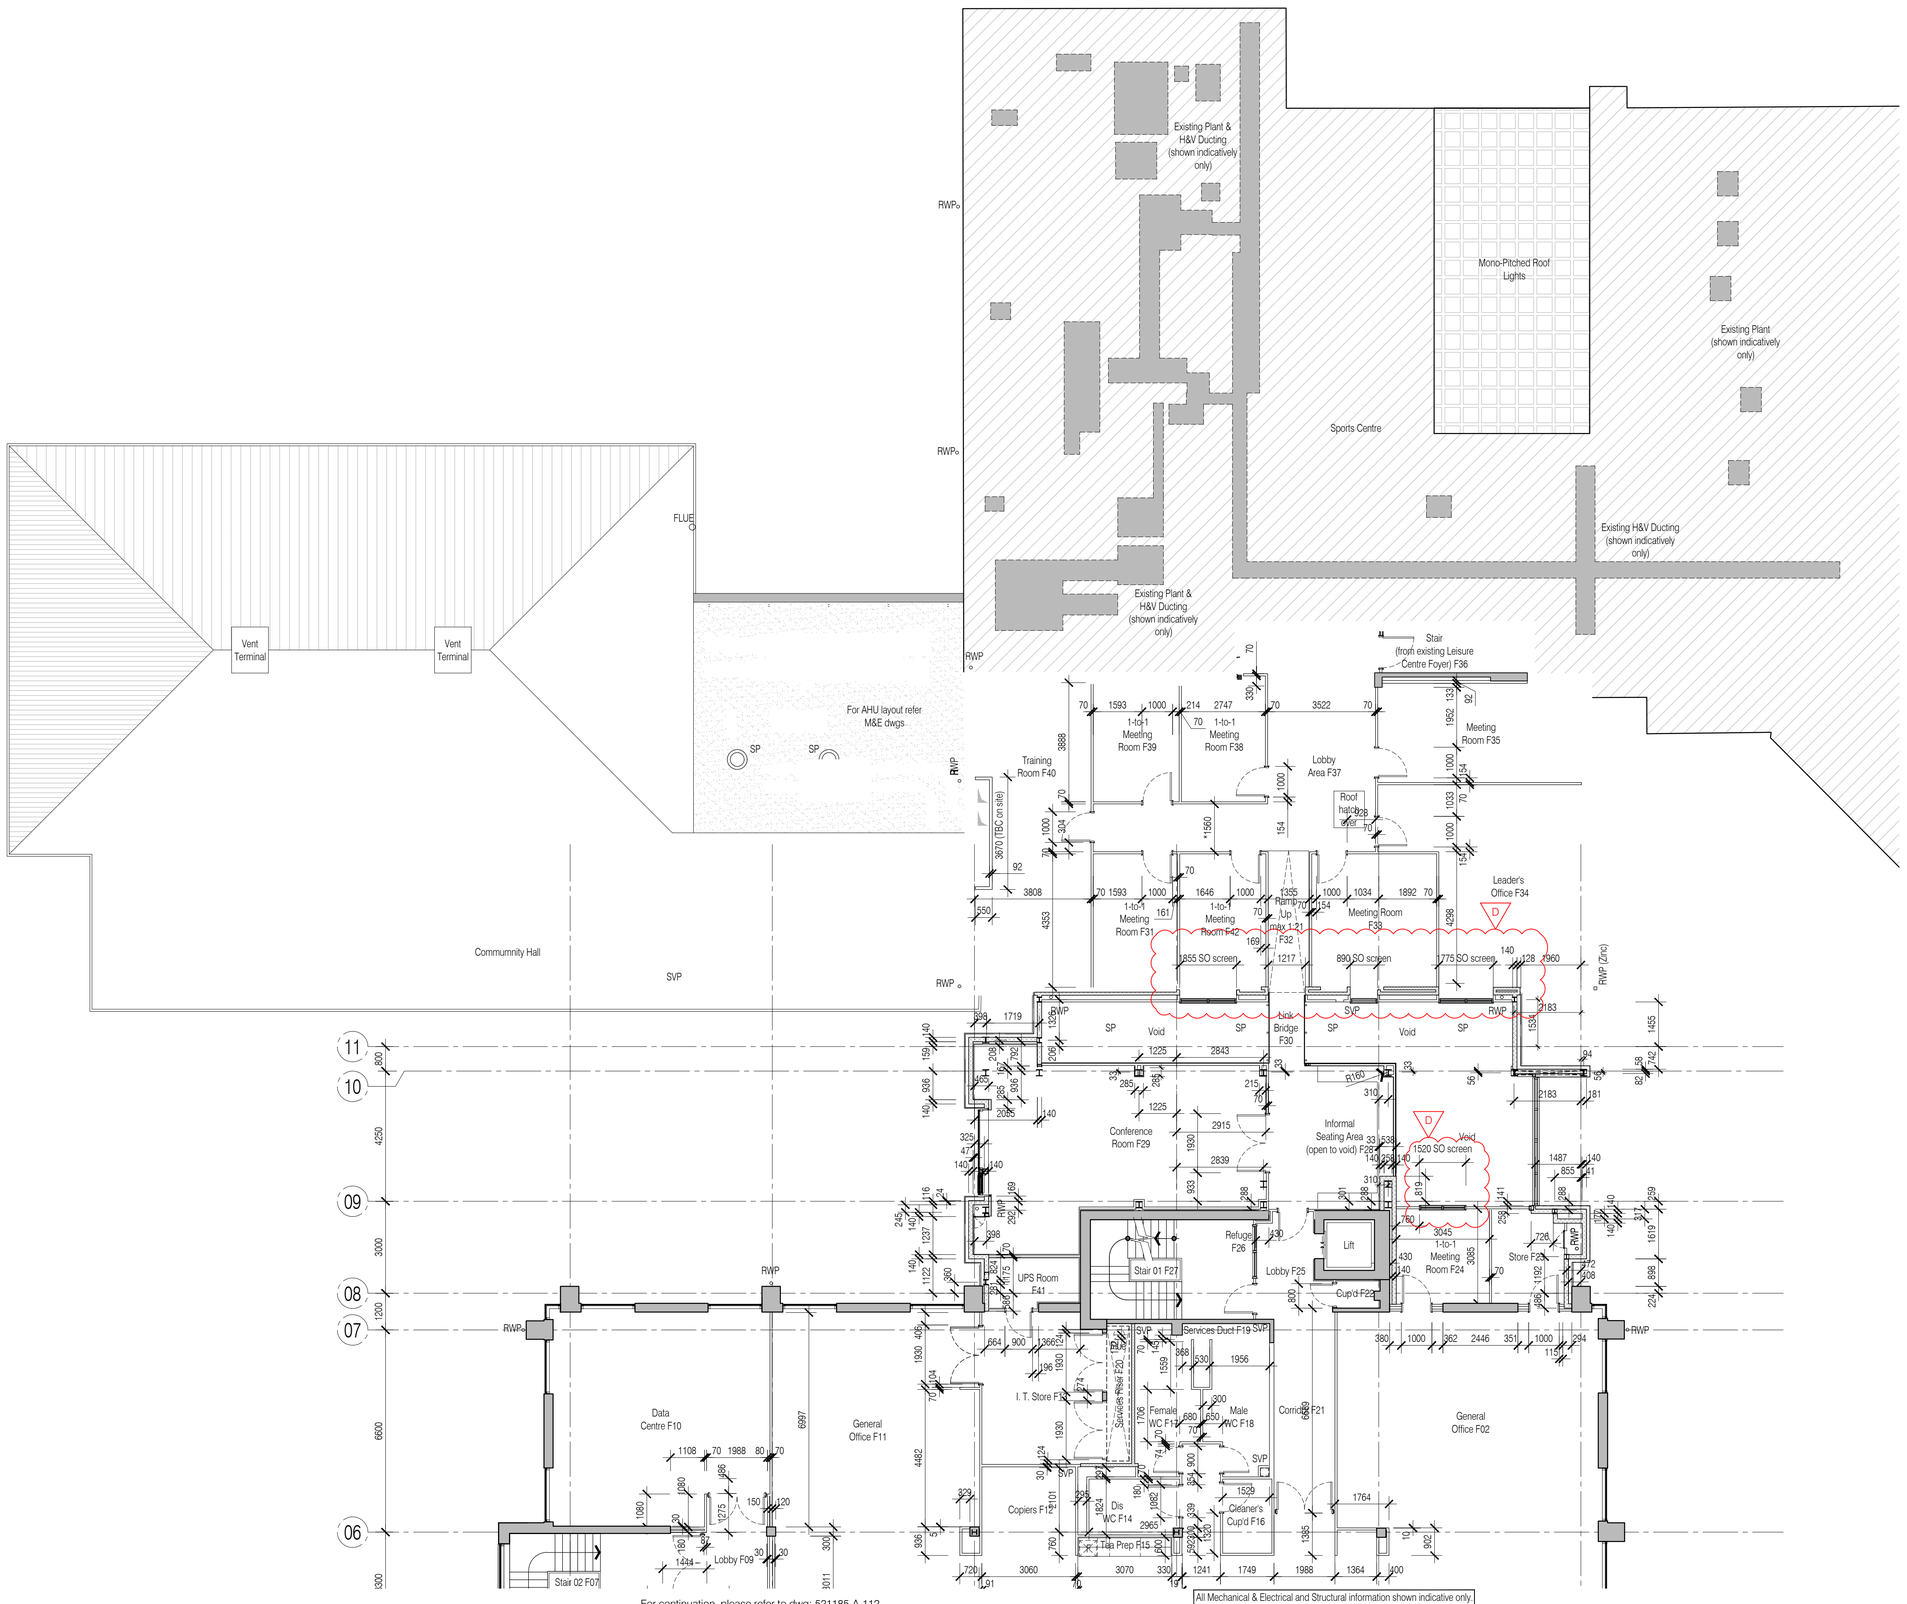

For continuation, please refer to dwg: 521185-A-112

NB: All information based on supplied third party survey information. All discrepancies to be reported to FCG immediately upon discovery.

All Mechanical & Electrical and Structural information shown indicative only. Please refer to Mechanical & Electrical and Structural documentation.

ISSUED FOR CONSTRUCTION

NB: - Solid gray hatch denotes existing building fabric.

Rev	Date	By	Chk	Comment
D	23.03.12	JAS	AC	Internal screen details / set-out finalised
C	22.12.11	JAS	AC	Minor setting-out amendments, as clouded
B	21.10.11	RKC	JAS	Meeting Room Suite revd
A	16.09.11	RKC	JAS	Status change - Issued for CONSTRUCTION

BRINGING IDEAS TO LIFE

FRANKHAM

Frankham Consultancy Group Limited
21 Perrymount Road
Haywards Heath RH16 3TP
t 01444 449900 f 01444 456642
enquire@frankham.com
www.frankham.com

Client
WILLMOTT DIXON CONSTRUCTION

Project Title
Wealden District Council
Hailsham Head Quarters
Refurbishments and Alterations

Drawing Title
Proposed First Floor Plan
Community Hall Building and Link Block
Setting Out Plan

Drawn by:	Scale:	Date:
RKC	1:100@A1	22.11.10
Designed by:	Checked by:	Approved by:
FCG	JAS	AC

File Ref.: X:\FRANKHAM\ZJOBS\521185-WEALDEN DC\ARCH\100_199_LOCATION PLANS AND GA\521185-A-113.DWG - 20061180925 20:06 11:16:03/04

Drawing No. 521185-A-113 | Rev. D