These drawings have been edited in accordance with Willmott Dixon's instructions. All material, product, volume, dimension and performance information is indicative only. FCG repudiate any and all liability for failure or non performance of any or the afore mentioned items as indicated on this or any other FCG documentation.

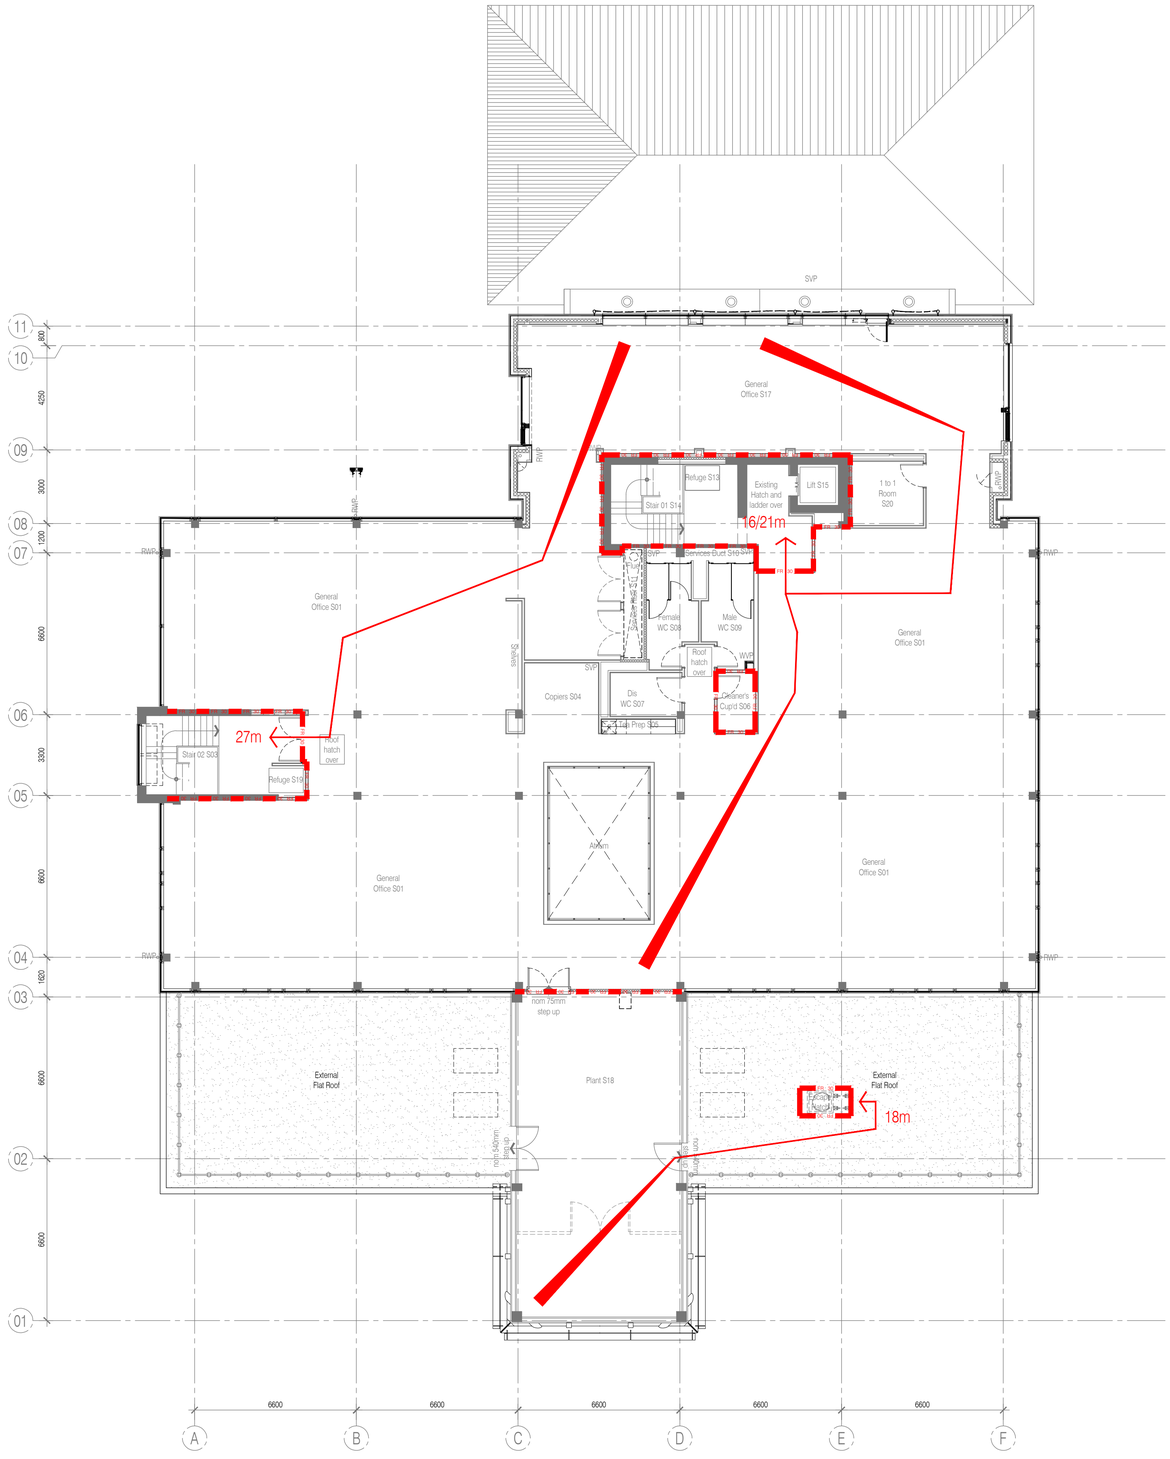

NB: All information based on supplied third party survey information. All discrepancies to be reported to FCG immediately upon discovery.

All Mechanical & Electrical and Structural information shown indicative only. Please refer to Mechanical & Electrical and Structural documentation.

NOTES: Do not scale this drawing. All dimensions to be checked on site prior to commencement or manufacture.

Key Plan
1:1000

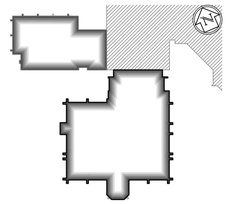

Fire Strategy Key

FR 30 FR 30 Denotes 30 minute fire rating partition

Denotes cavity barriers to extg floor voids

Refer also to the following FCG drawings:
For 'GA Plans', refer to drawings 'A-100-Series'.
For 'GA Sections', refer to drawings 'A-200-Series'.
For 'GA Elevations', refer to drawings 'A-300-Series'.
For 'Acoustic Strategy', refer to drawings 'A-150-Series'.
For 'Internal Partition Strategy', refer to drawings 'A-170-Series'.
For 'Builder's Work', refer to drawings 'A-180-Series'.
Refer also to detailed drawings generally - 'A-400-Series + NBS.

AS BUILT DRAWING

NB: - Solid gray hatch denotes existing building fabric.

Rev	Date	By	Chk	Comment
-	-	-	-	-

BRINGING IDEAS TO LIFE

FRANKHAM

Frankham Consultancy Group Limited
21 Perrymount Road
Haywards Heath RH16 3TP
t 01444 444900 f 01444 456542
enquire@frankham.com
www.frankham.com

Client
WILLMOTT DIXON CONSTRUCTION

Project Title
Wealden District Council
Hailsham Head Quarters
Refurbishments and Alterations

Drawing Title
Proposed Second Floor Plan
Council Offices Building
Fire Strategy Plan

Drawn by:	Scale:	Date:
RKC	1:125@A1	16.12.10
Designed by:	Checked by:	Approved by:
FCG	RKC	AC

File Ref.: X:\FRANKHAM\2JOBS\521185-WEALDEN-DC\ARCH\3D_199_LOCATION PLANS AND GA\521185-A-162.DWG - 20061190718 20:06:11 16:07:17

Drawing No. 521185-A-162 Rev. -