




01 Detail  
Scale: 1:5

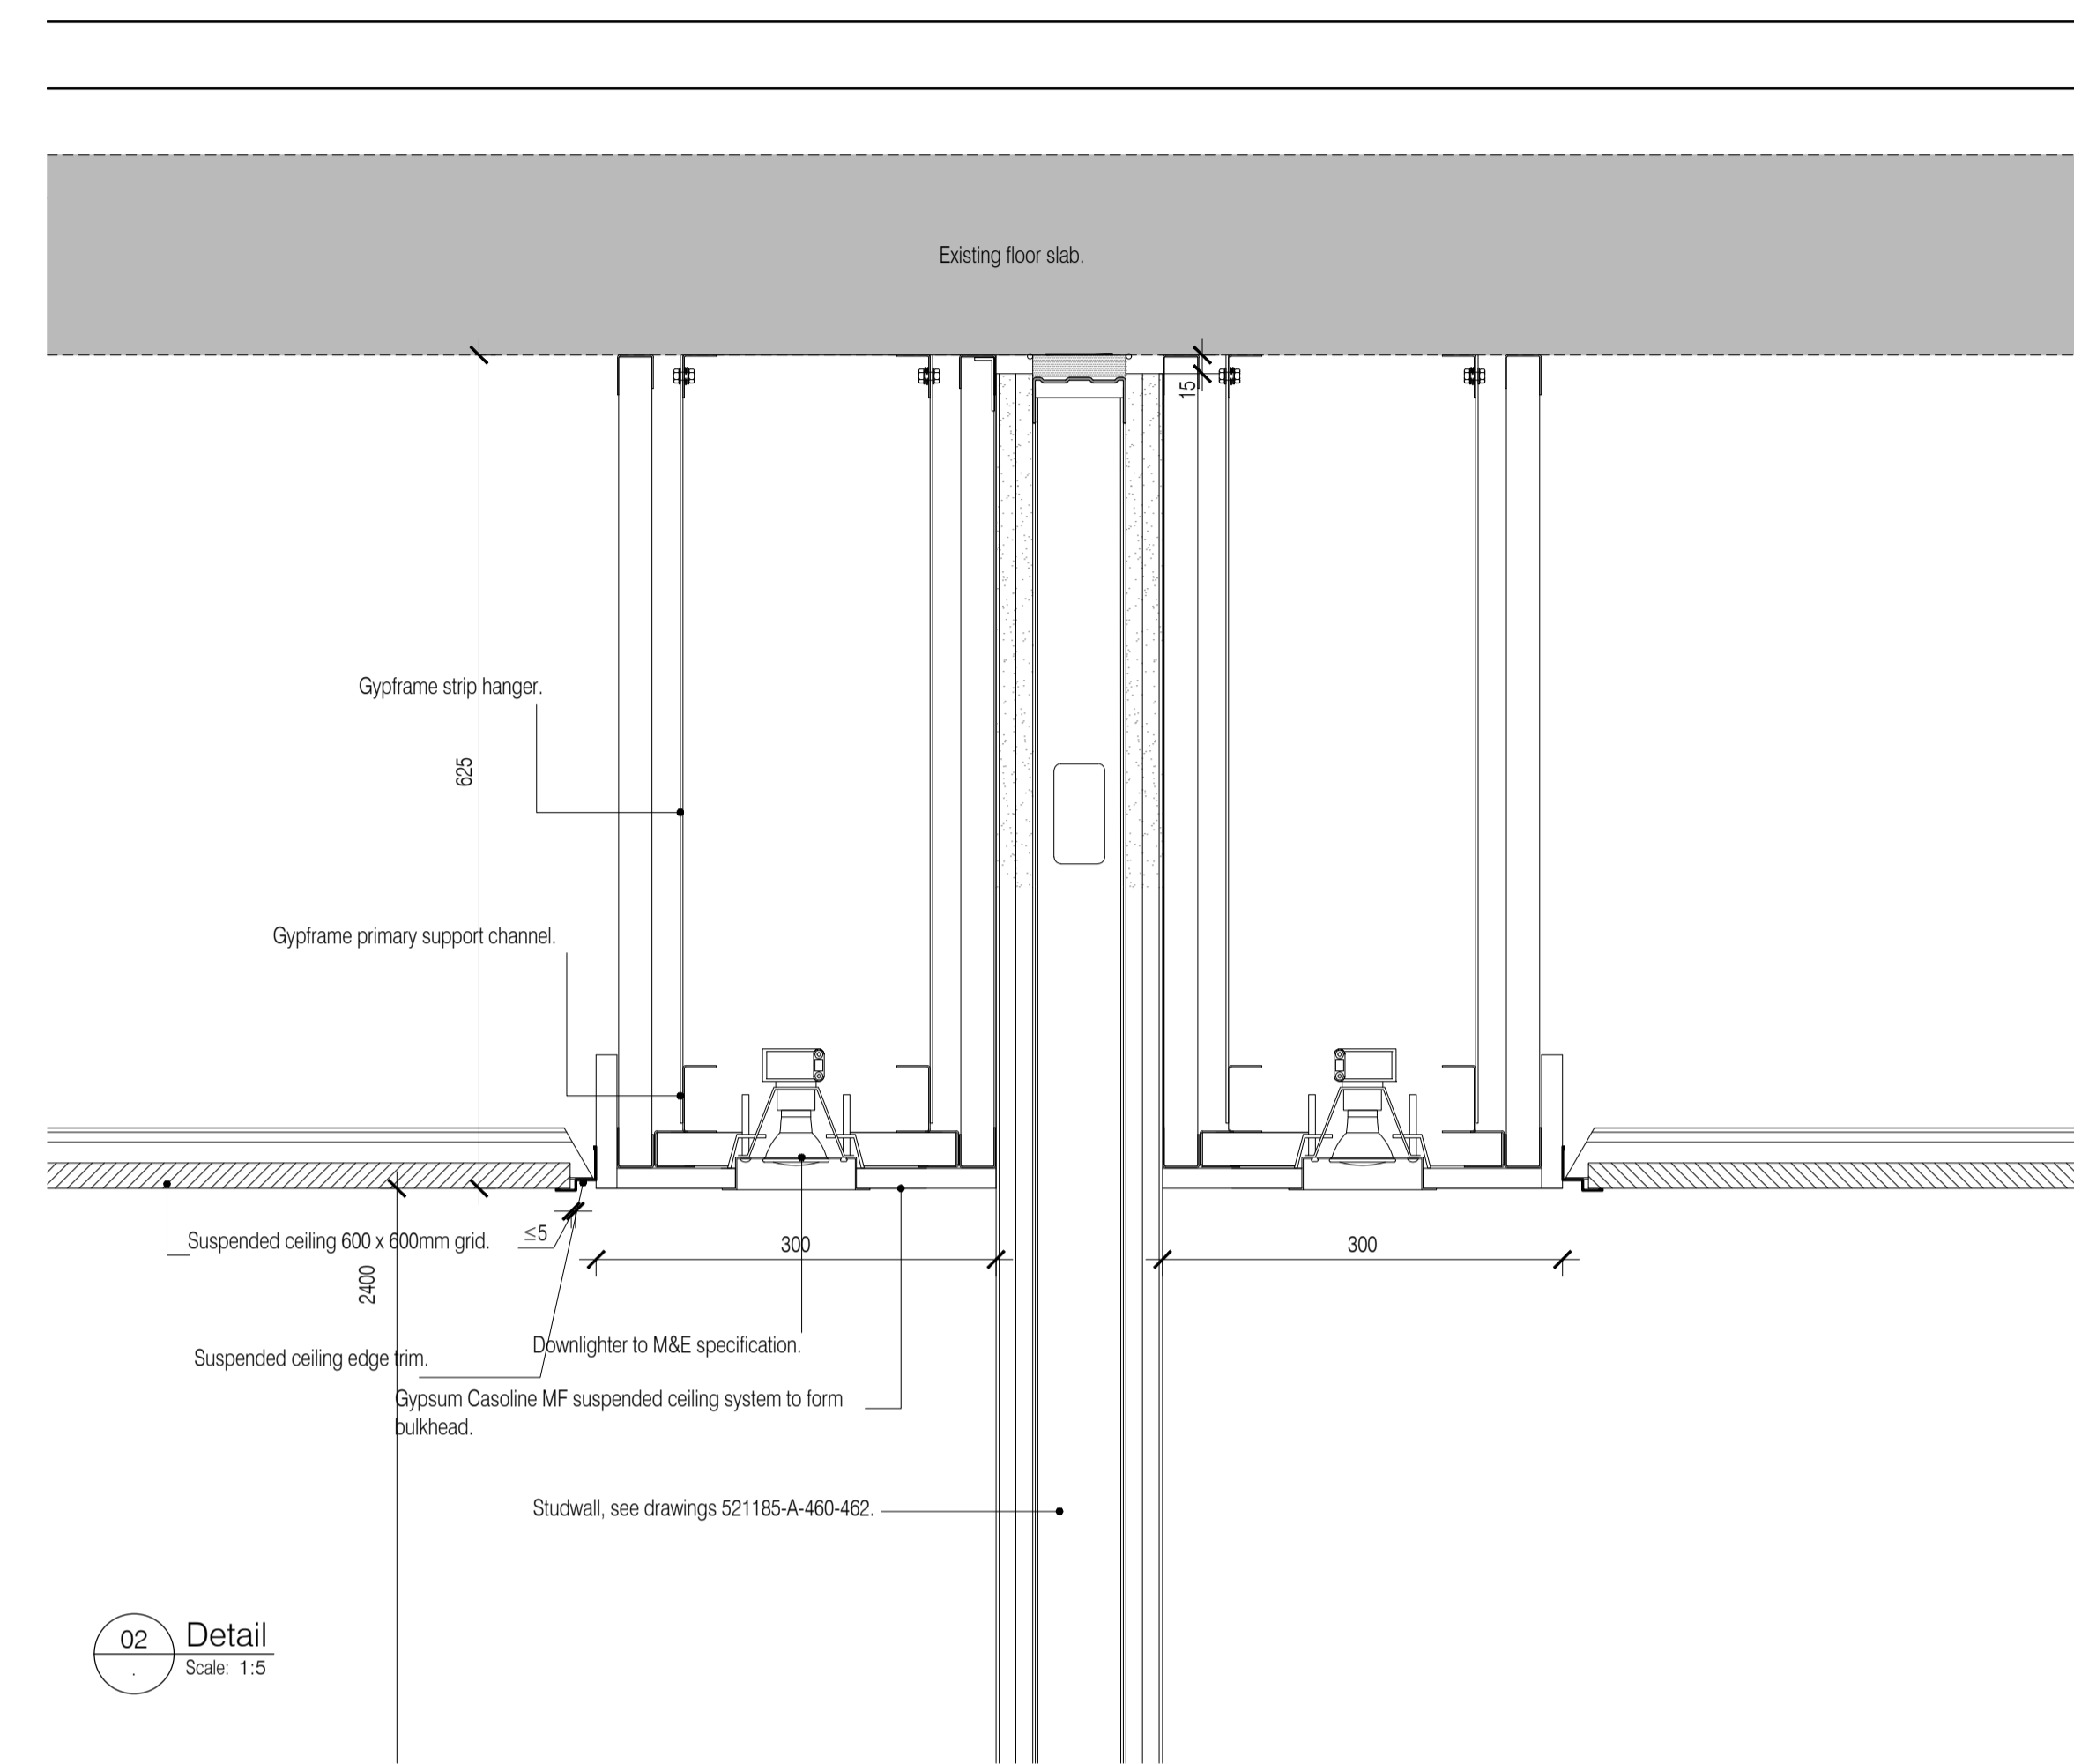


02 Detail  
Scale: 1:5

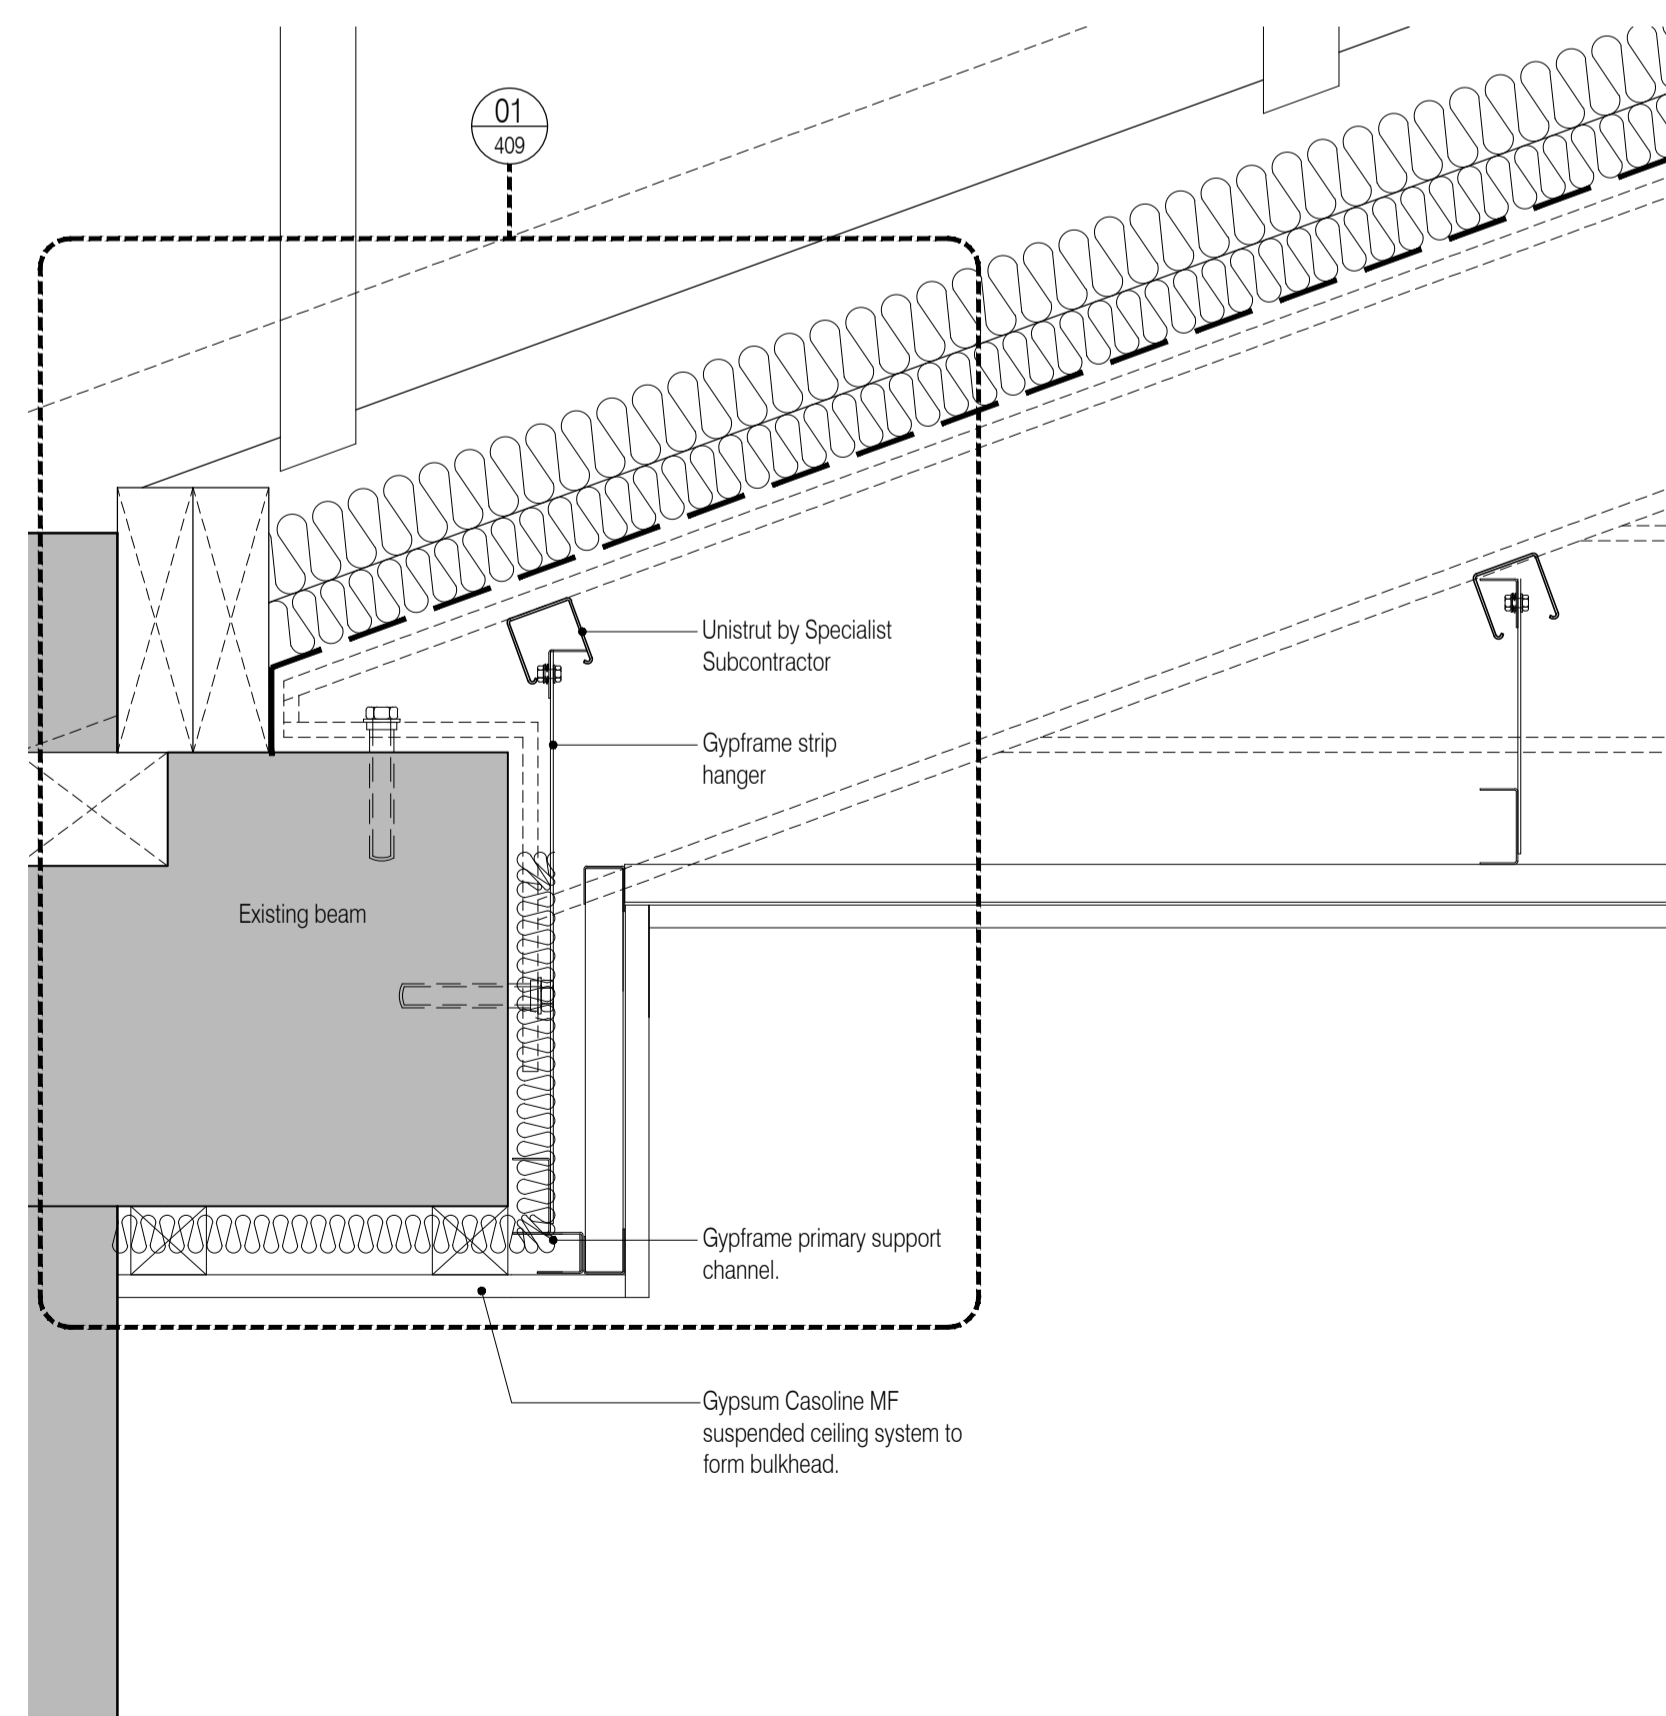

03 Detail  
Scale: 1:5

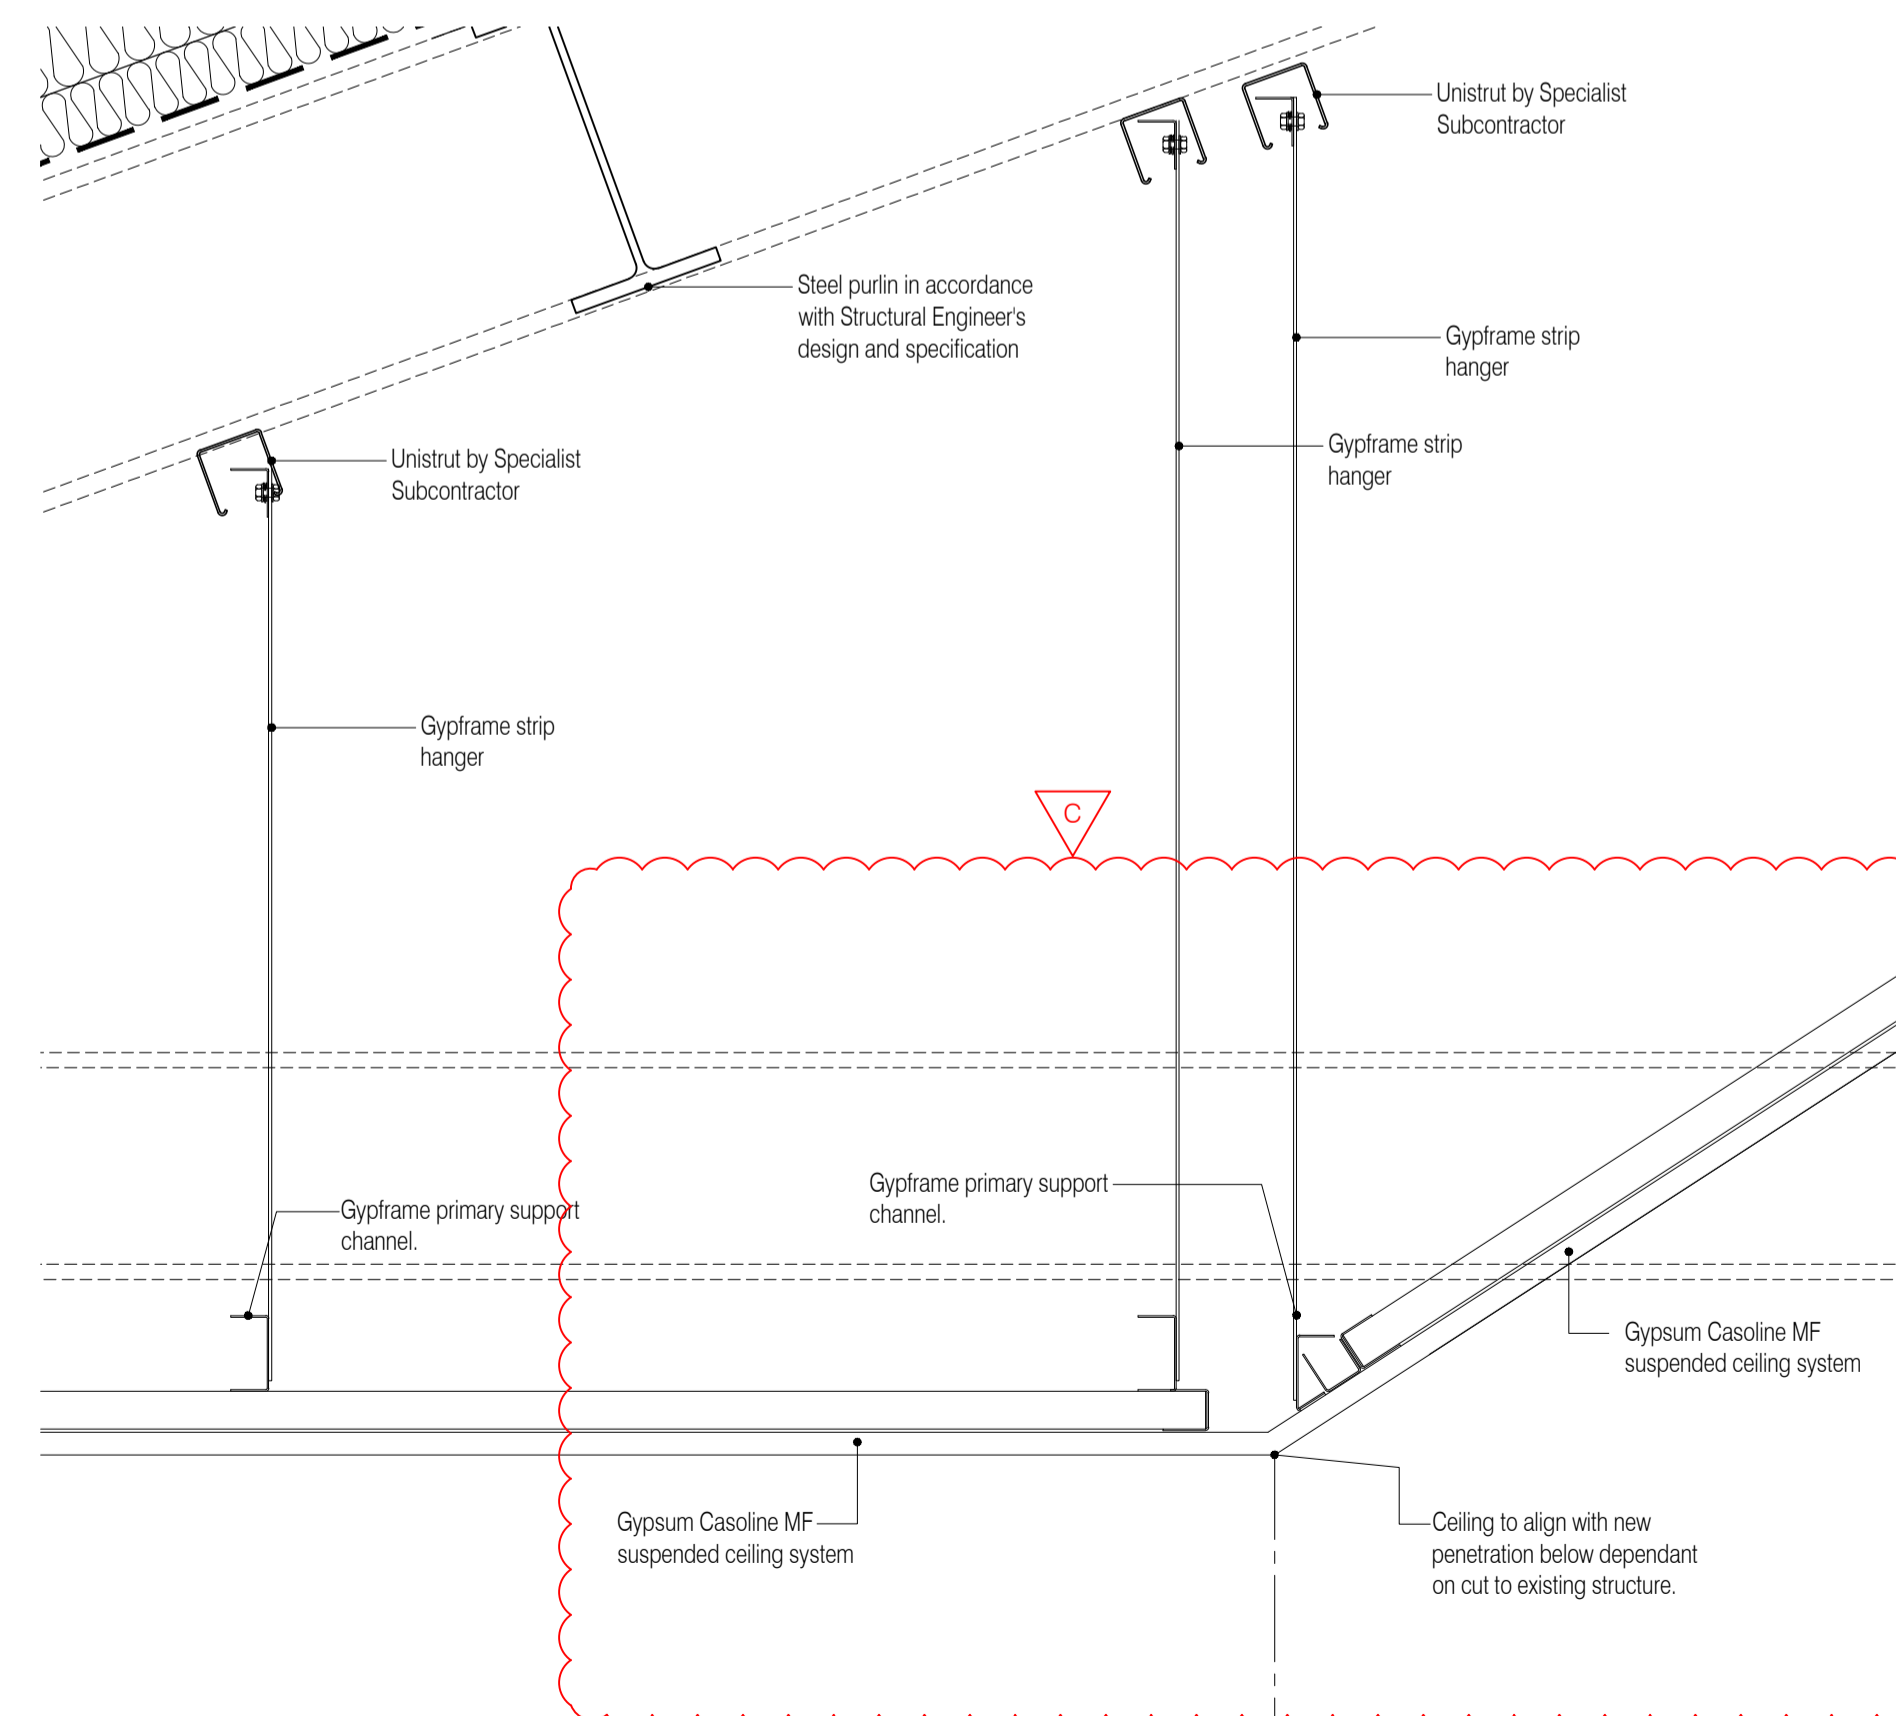


04 Detail  
Scale: 1:5

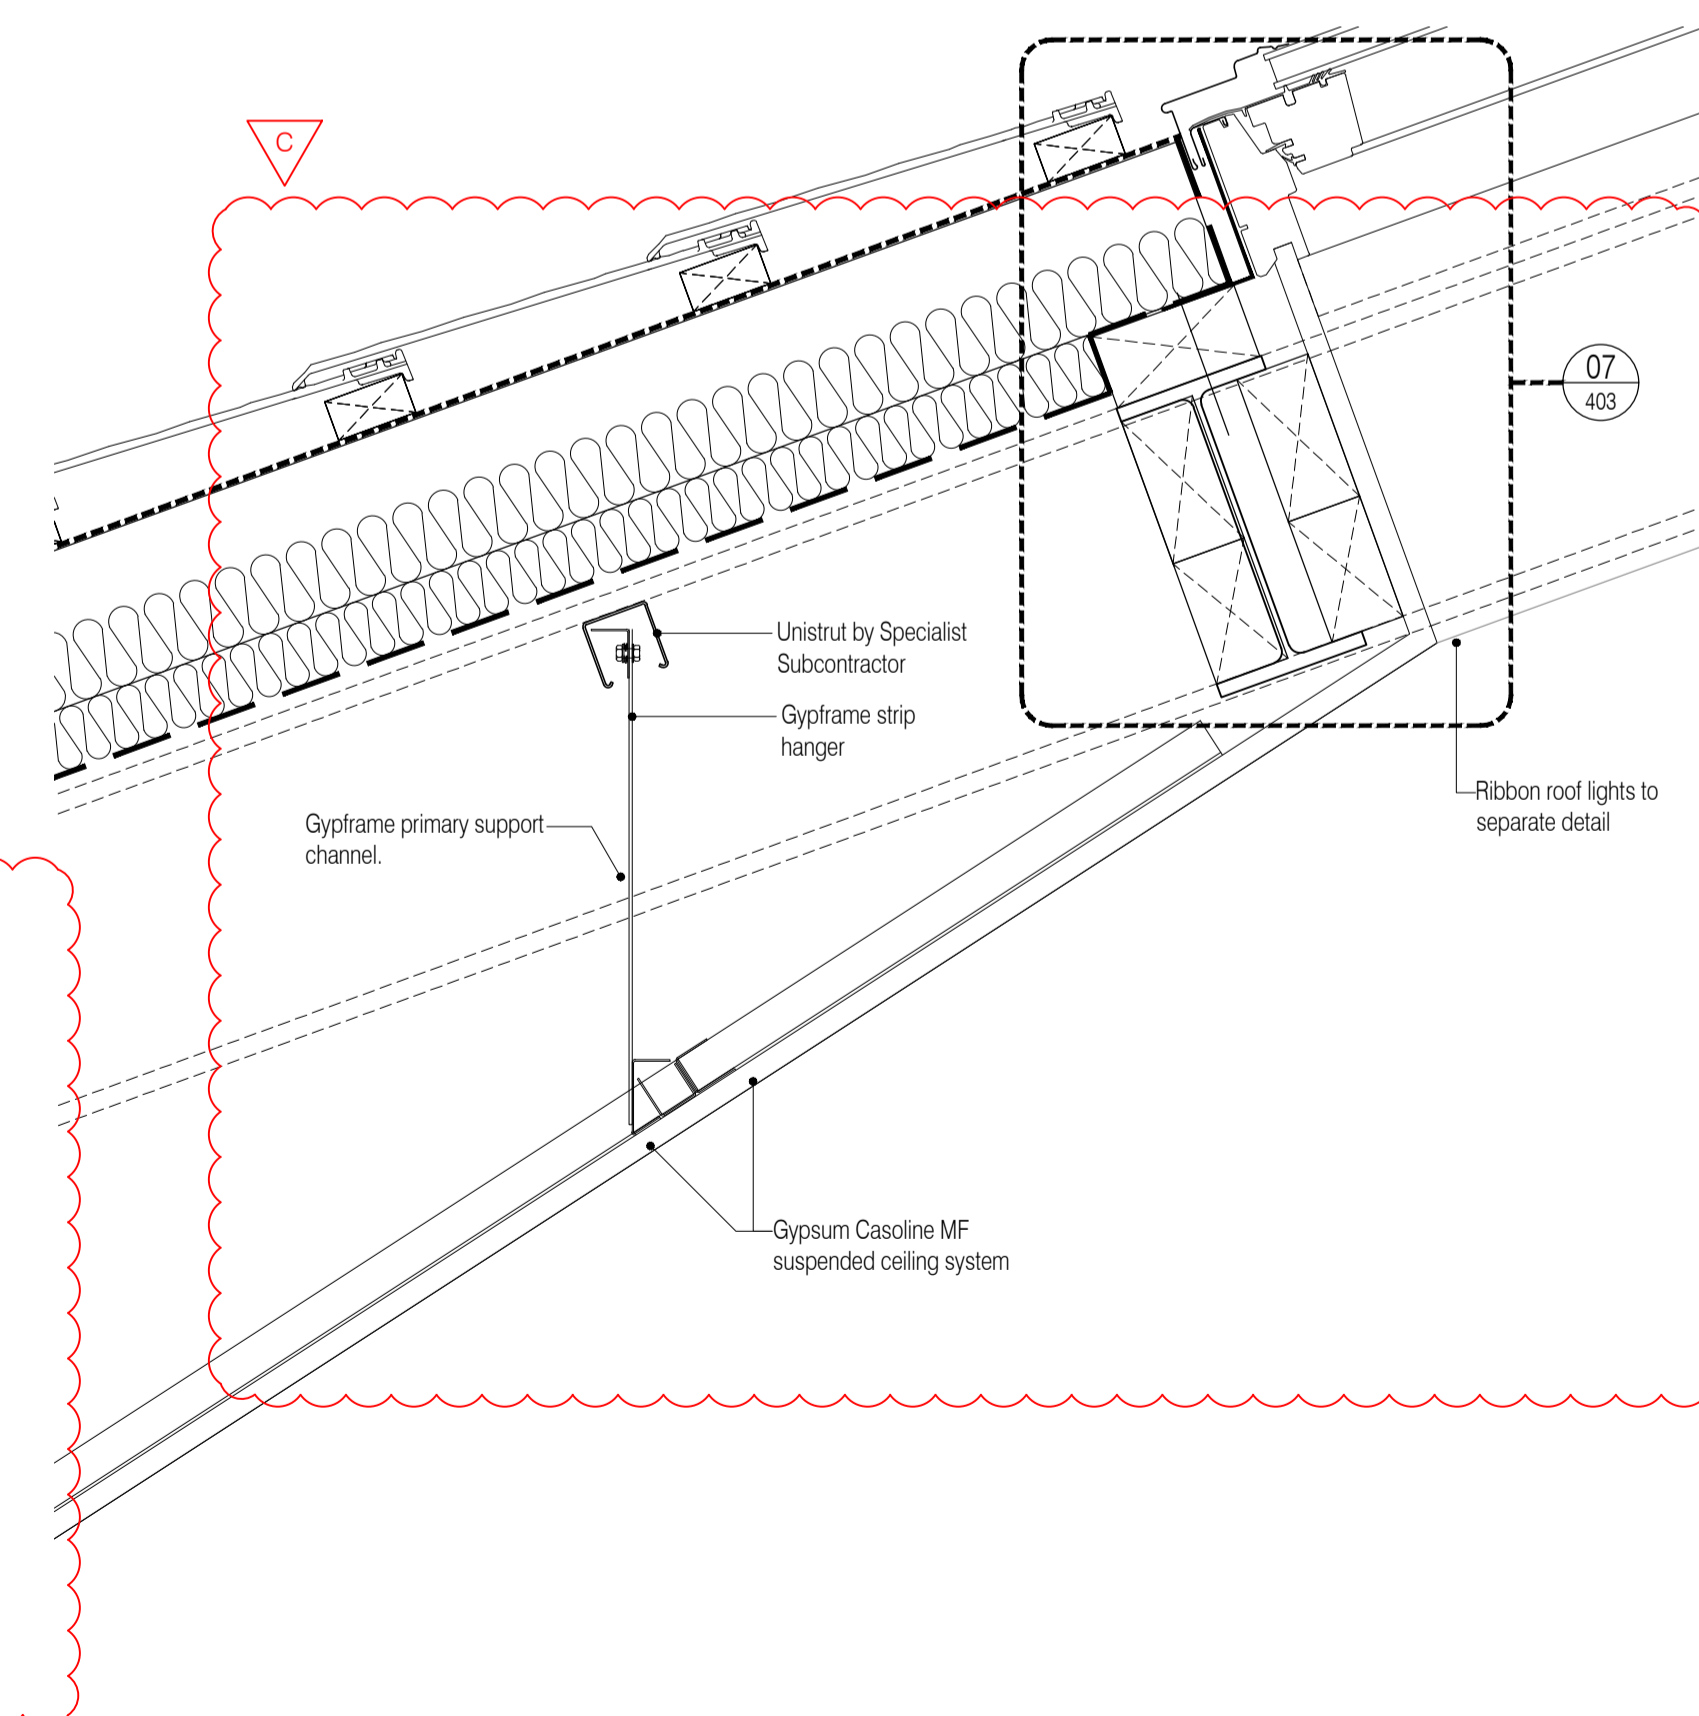

05 Detail  
Scale: 1:5

NOTES: Do not scale this drawing. All dimensions to be checked on site prior to commencement or manufacture.

Key Plan  
1:1000

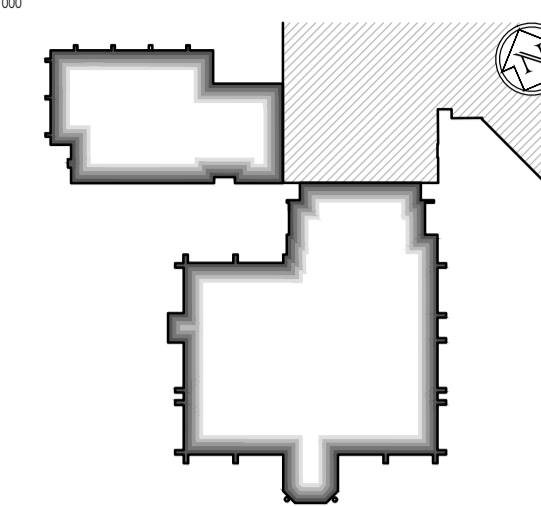

ISSUED FOR CONSTRUCTION

NB: - Solid gray hatch denotes existing building fabric.

Rev	Date	By	Chk	Comment
C	21.12.11	JAS	AC	Ceiling amended to crisp corners (no steps)
B	13.10.11	RKC	JAS	Explanatory setting out note added
A	16.09.11	RKC	JAS	Status change - Issued for CONSTRUCTION

BRINGING IDEAS TO LIFE



FRANKHAM

Frankham Consultancy Group Limited  
21 Perryman Road  
Haywards Heath RH16 3TP  
t 01444 444900 f 01444 455642  
enquire@frankham.com  
www.frankham.com

Client  
WILLMOTT DIXON CONSTRUCTION

Project Title  
Wealden District Council  
Hailsham Head Quarters  
Refurbishments and Alterations

Drawing Title  
Suspended ceiling and bulkhead  
Perimeter details  
Sheet 4

Drawn by: RKC	Scale: 1:5 @A1	Date: 28.06.11
Designed by: FCG	Checked by: JAS	Approved by: AC

File Ref.: X:\FRANKHAM\2012\18\WALDEN\DOORWAY\_460\_DETAL\_SHEMATIC\_521185-A-473.dwg 20/06/11 16:26:43

Drawing No. 521185-A-473	Rev. C
-----------------------------	-----------

NB: All information based on supplied third party survey information. All discrepancies to be reported to FCG immediately upon discovery.