


All Disabled and Ambulant Disabled facilities to comply with Approved Document Part M - "Access to and use of buildings", Equality Act and BS83000 as required.

NB: All levels are approximate and are subject to further site investigation prior to construction. All discrepancies to be reported to FCG immediately.



NOTES: Do not scale this drawing. All dimensions to be checked on site prior to commencement or manufacture. Key Plan (nts)

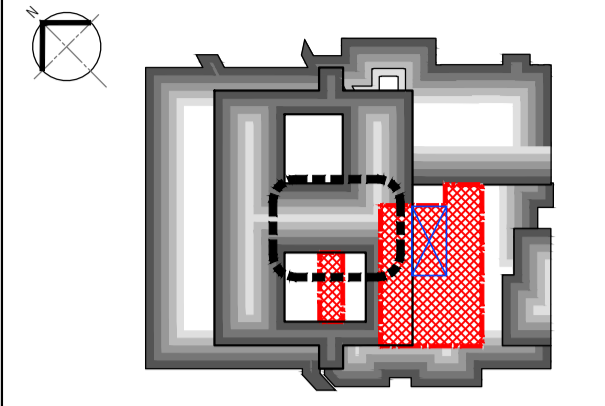

Window Reference Legend
 Denotes floor level: 01 or 02
 Denotes Window opening
 Denotes elevation: W, S, or E
 Denotes opening n°


Door & Screen Reference Legend
 Denotes floor level
 Denotes opening type: Door or Screen
 Denotes room n°
 Denotes opening n°

PRELIMINARY ISSUE

All details referenced in call outs supersede general arrangement or larger depictions.

Rev	Date	By	CHK	Comment
P2	12.06.20	RKC	AJM	Isolation Ward Works Added
P1	04.11.13	RKC	AGC	Preliminary Issue for Information

BRINGING IDEAS TO LIFE



FRANKHAM

Frankham Consultancy Group Limited
 21 Plympton Road
 Heywards Heath PO11 8 3TP
 t 01444 444000 f 01444 455642
 enquiry@frankham.com
 www.frankham.com

Client
St George's Healthcare NHS Trust

Project Title
 General Intensive Care Unit Extension
 St. James Wing
 St. Georges Hospital
 London

Drawing Title
 Proposed
 Third Floor / Roof
 General Arrangement Plan
 North West Quadrant

Drawn by: FCG	Scale: 1:50@A1	Date: 03.10.13
Designed by: FCG	Checked by: MDK	Approved by: AGC

File Ref.: X:\FRANKHAM\2-08612117\02\ARCH\100-04A-521717-A-123-1.DWG - 2008174003 20.06.12:14:38:33

Drawing No. 521717-A-123-1	Rev. P2
-------------------------------	------------

NB: All information based on supplied third party survey information. All discrepancies to be reported to FCG immediately upon discovery.

All Mechanical & Electrical and Structural information shown indicative only. Please refer to Mechanical & Electrical and Structural documentation.