All partition information, details and specifications subject to confirmation by Drywall Contractor and are to be in accordance with Manufacturer's design and instructions. Architect to be notified immediately upon discovery of variation to the details shown.

NB: All levels are approximate and are subject to further site investigation prior to construction. All discrepancies to be reported to FCG immediately

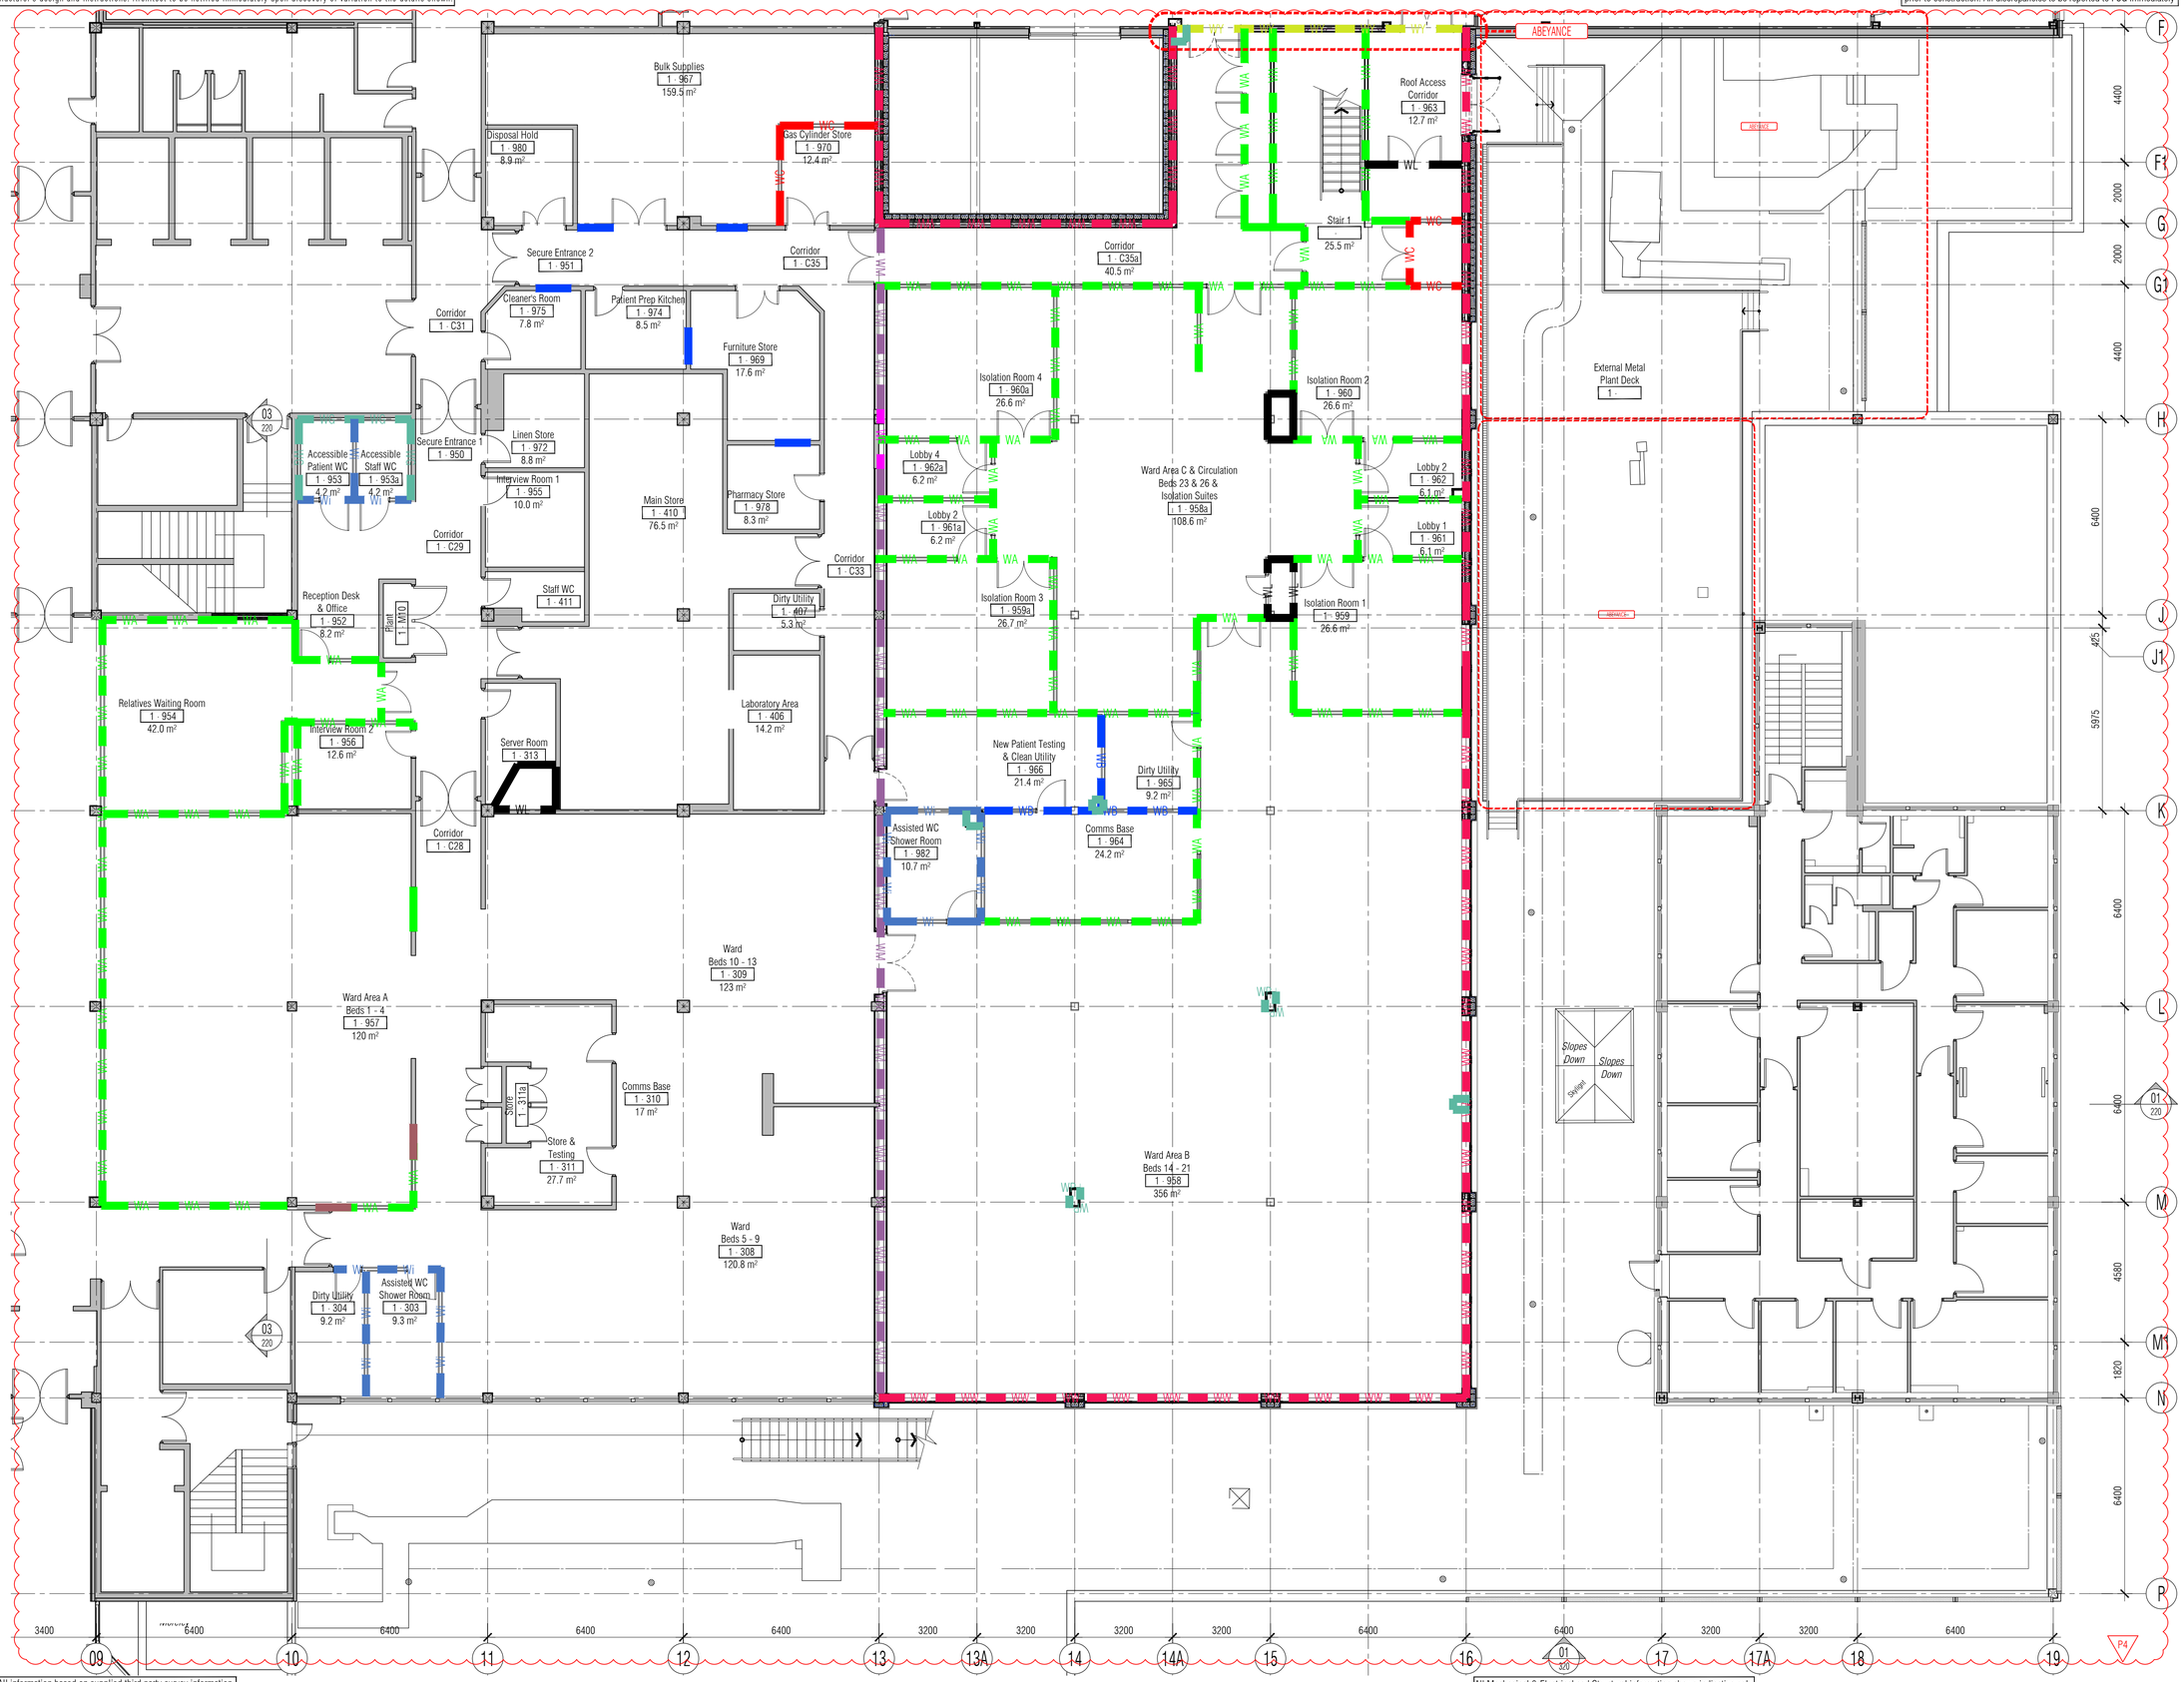

NB: All information based on supplied third party survey information. All discrepancies to be reported to FCG immediately upon discovery.

All Mechanical & Electrical and Structural information shown indicative only. Please refer to Mechanical & Electrical Structural documentation.

NOTES: Do not scale this drawing. All dimensions to be checked on site prior to commencement or manufacture.

Key Plan (nts)

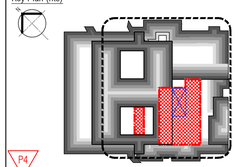

P4

Partition Strategy Key

To be read in conjunction with

Wall Types dwgs	521717-A-530 - 535	and
Partition Strategy dwgs	521717-A-160 - 165	and
Partition Detail dwgs	521717-A-500 - 509	

Internal Walls

Wall Type A	WA	WA	WA	WA
Wall Type B	WB	WB	WB	WB
Wall Type C	WC	WC	WC	WC
Wall Type D	WD	WD	WD	WD
Wall Type E	WE	WE	WE	WE
Wall Type F	WF	WF	WF	WF
Wall Type G	WG	WG	WG	WG
Wall Type H	WH	WH	WH	WH
Wall Type i	Wi	Wi	Wi	Wi
Wall Type J	WJ	WJ	WJ	WJ
Wall Type K	WK	WK	WK	WK
Wall Type L	WL	WL	WL	WL
Wall Type M	WM	WM	WM	WM
Wall Type N	WN	WN	WN	WN
Wall Type O	WO	WO	WO	WO
Wall Type P	WP	WP	WP	WP

External Walls

Wall Type W	WW	WW	WW	WW
Wall Type X	WX	WX	WX	WX
Wall Type Y	WY	WY	WY	WY
Wall Type Z	WZ	WZ	WZ	WZ

P4

Typical General Arrangement DWG N° Key

Stage: 1-Existing, 2-Demolition, 3+ -Proposals — Level N°

Job N° — Sheet series N°: 0= Extents, 1-5= Zones

Discipline — Dwg Series

521717-A-121-0

BUILDING REGS ISSUE

All details referenced in call outs supercede general arrangement or larger depictions.

Rev	Date	By	Chk	Comment
P4	24.03.14	RKC	AJM	Issued for Building Regulations Approval
P3	11.02.14	RKC	AJM	General Updates
P2	23.12.13	RKC	AJM	General amendments to layout
P1	13.12.13	RKC	MK	Issued for Approval

BRINGING IDEAS TO LIFE

FRANKHAM

Frankham Consultancy Group Limited
21 Perrymount Road
Haywards Heath RH16 3TP
t 01444 444900 f 01444 455642
enquire@frankham.com
www.frankham.com

Client

St George's Healthcare NHS
NHS Trust

Project Title

General Intensive Care Unit Extension
St. James Wing
St. Georges Hospital
London

Drawing Title

Proposed
First Floor
Partition Strategy
Plan

Drawn by:	Scale:	Date:
RKC	1:100@A1	03.10.13
Designed by:	Checked by:	Approved by:
FCG	MDK	AGC

File Ref.: K:\FRAMWHM\Z-JOBS\521717-GOJ\ARCH\100-GA\ - 521717-A-161.DWG - 20061310413 20:06:12:15:34:50

Drawing No. 521717-A-161

Rev. P4