
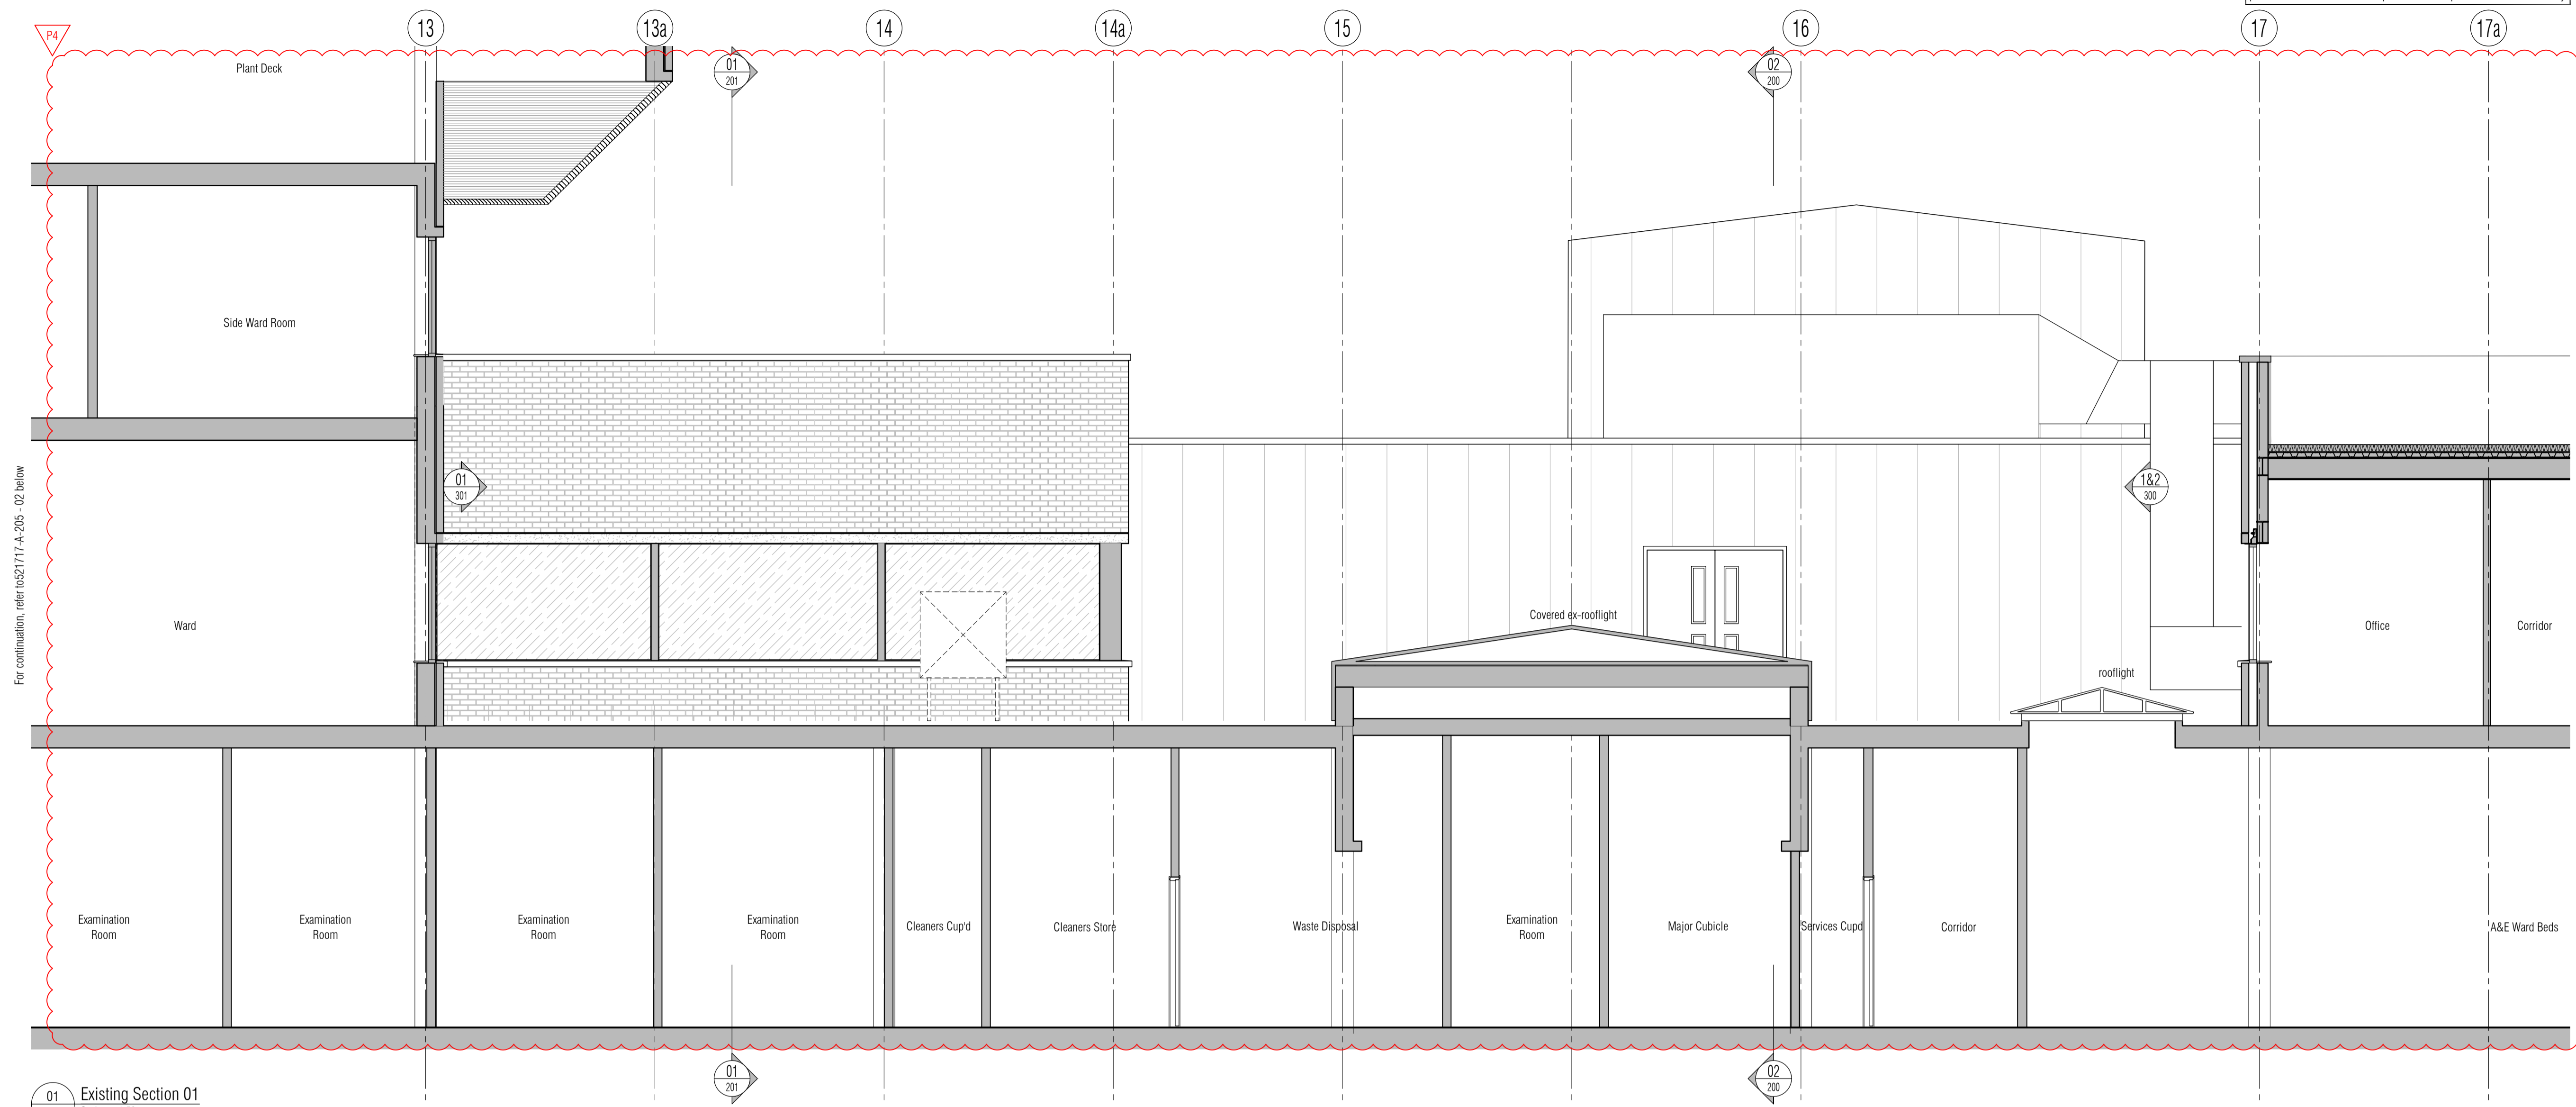


NB: All levels are approximate and are subject to further site investigation prior to construction. All discrepancies to be reported to FCG immediately.

NOTES: Do not scale this drawing. All dimensions to be checked on site prior to commencement or manufacture.
Key Plan (nts)

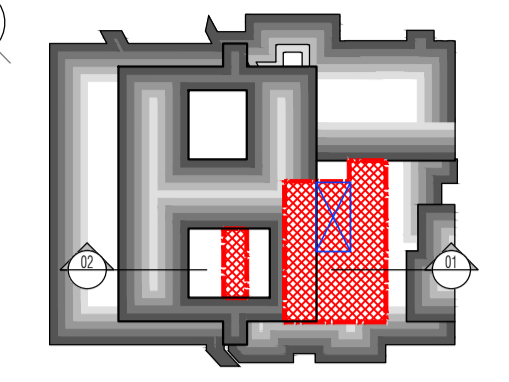


01 Existing Section 01
Scale: 1:50

**BUILDING
REGS ISSUE**

All details referenced in call outs supercede general arrangement or larger depictions.

Rev	Date	By	CHK	Comment
P4	24.03.14	RKC	ALM	Issued for Building Regulations Approval
P3	21.01.14	RKC	ALM	Lightwell extension zone added
P2	22.11.13	RKC	ALM	General update
P1	01.11.13	RKC	AGC	Preliminary issue for information

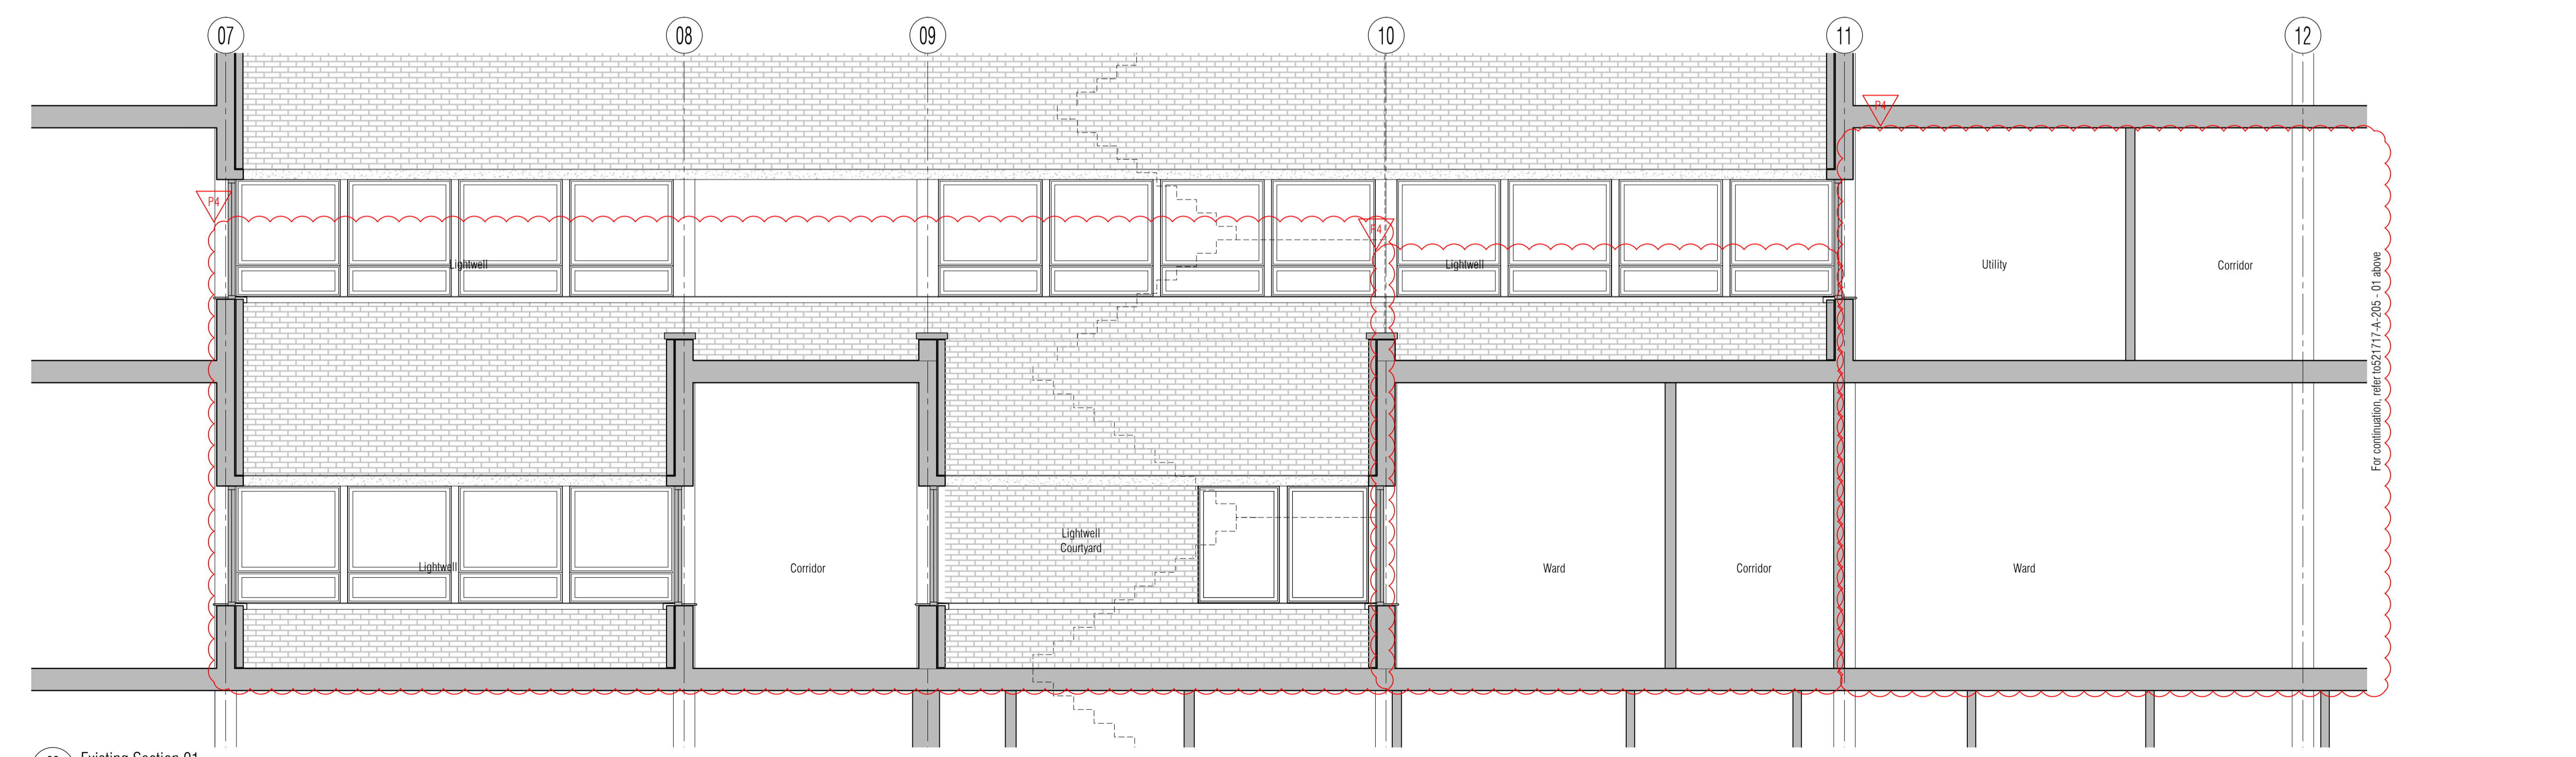

02 Existing Section 01
Scale: 1:50

BRINGING IDEAS TO LIFE

FRANKHAM

Frankham Consultancy Group Limited
21 Perrymount Road
Haywards Heath RH16 3TP
t 01444 444900 f 01444 455642
enquire@frankham.com
www.frankham.com

Client
St George's Healthcare NHS Trust

Project Title
General Intensive Care Unit Extension
St. James Wing
St. Georges Hospital
London

Drawing Title
Existing
Section 01

Drawn by: RKC	Scale: 1:50@A1	Date: 03.10.13
Designed by: FCG	Checked by: MDK	Approved by: AGC

File Ref: X:\FRANKHAM\2-08012111-003\ARCH\006-001-2011-A-205-005.dwg 20.06.12:16:35:36

Drawing No:
521717-A-205

Rev:
P4

NB: All information based on supplied third party survey information. All discrepancies to be reported to FCG immediately upon discovery.

All Mechanical & Electrical and Structural information shown indicative only. Please refer to Mechanical & Electrical and Structural documentation.