




01 Existing Column with Glazing / Solid Return Detail
Scale: 1:5 @ A1

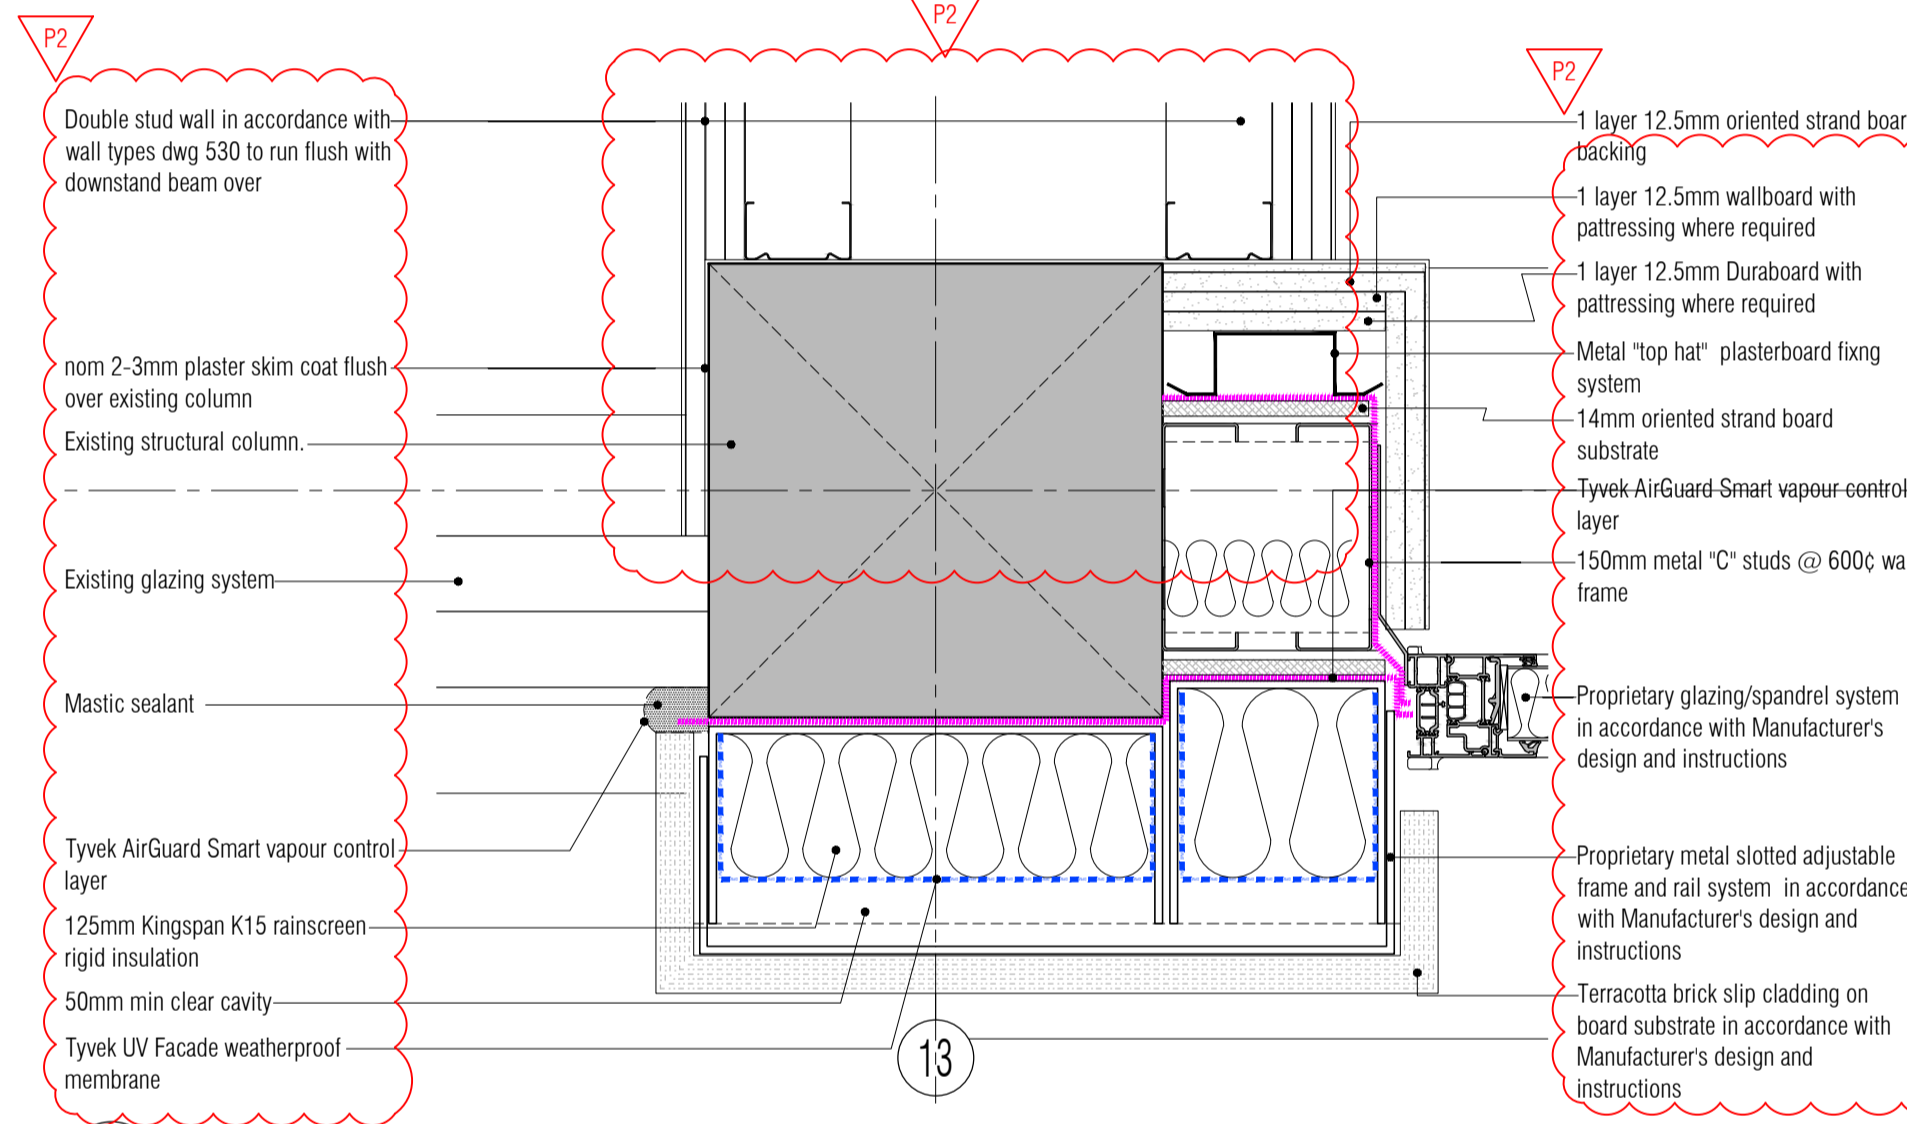


02 Existing Column with Glazing / Glazed Cladding Column Detail
Scale: 1:5 @ A1

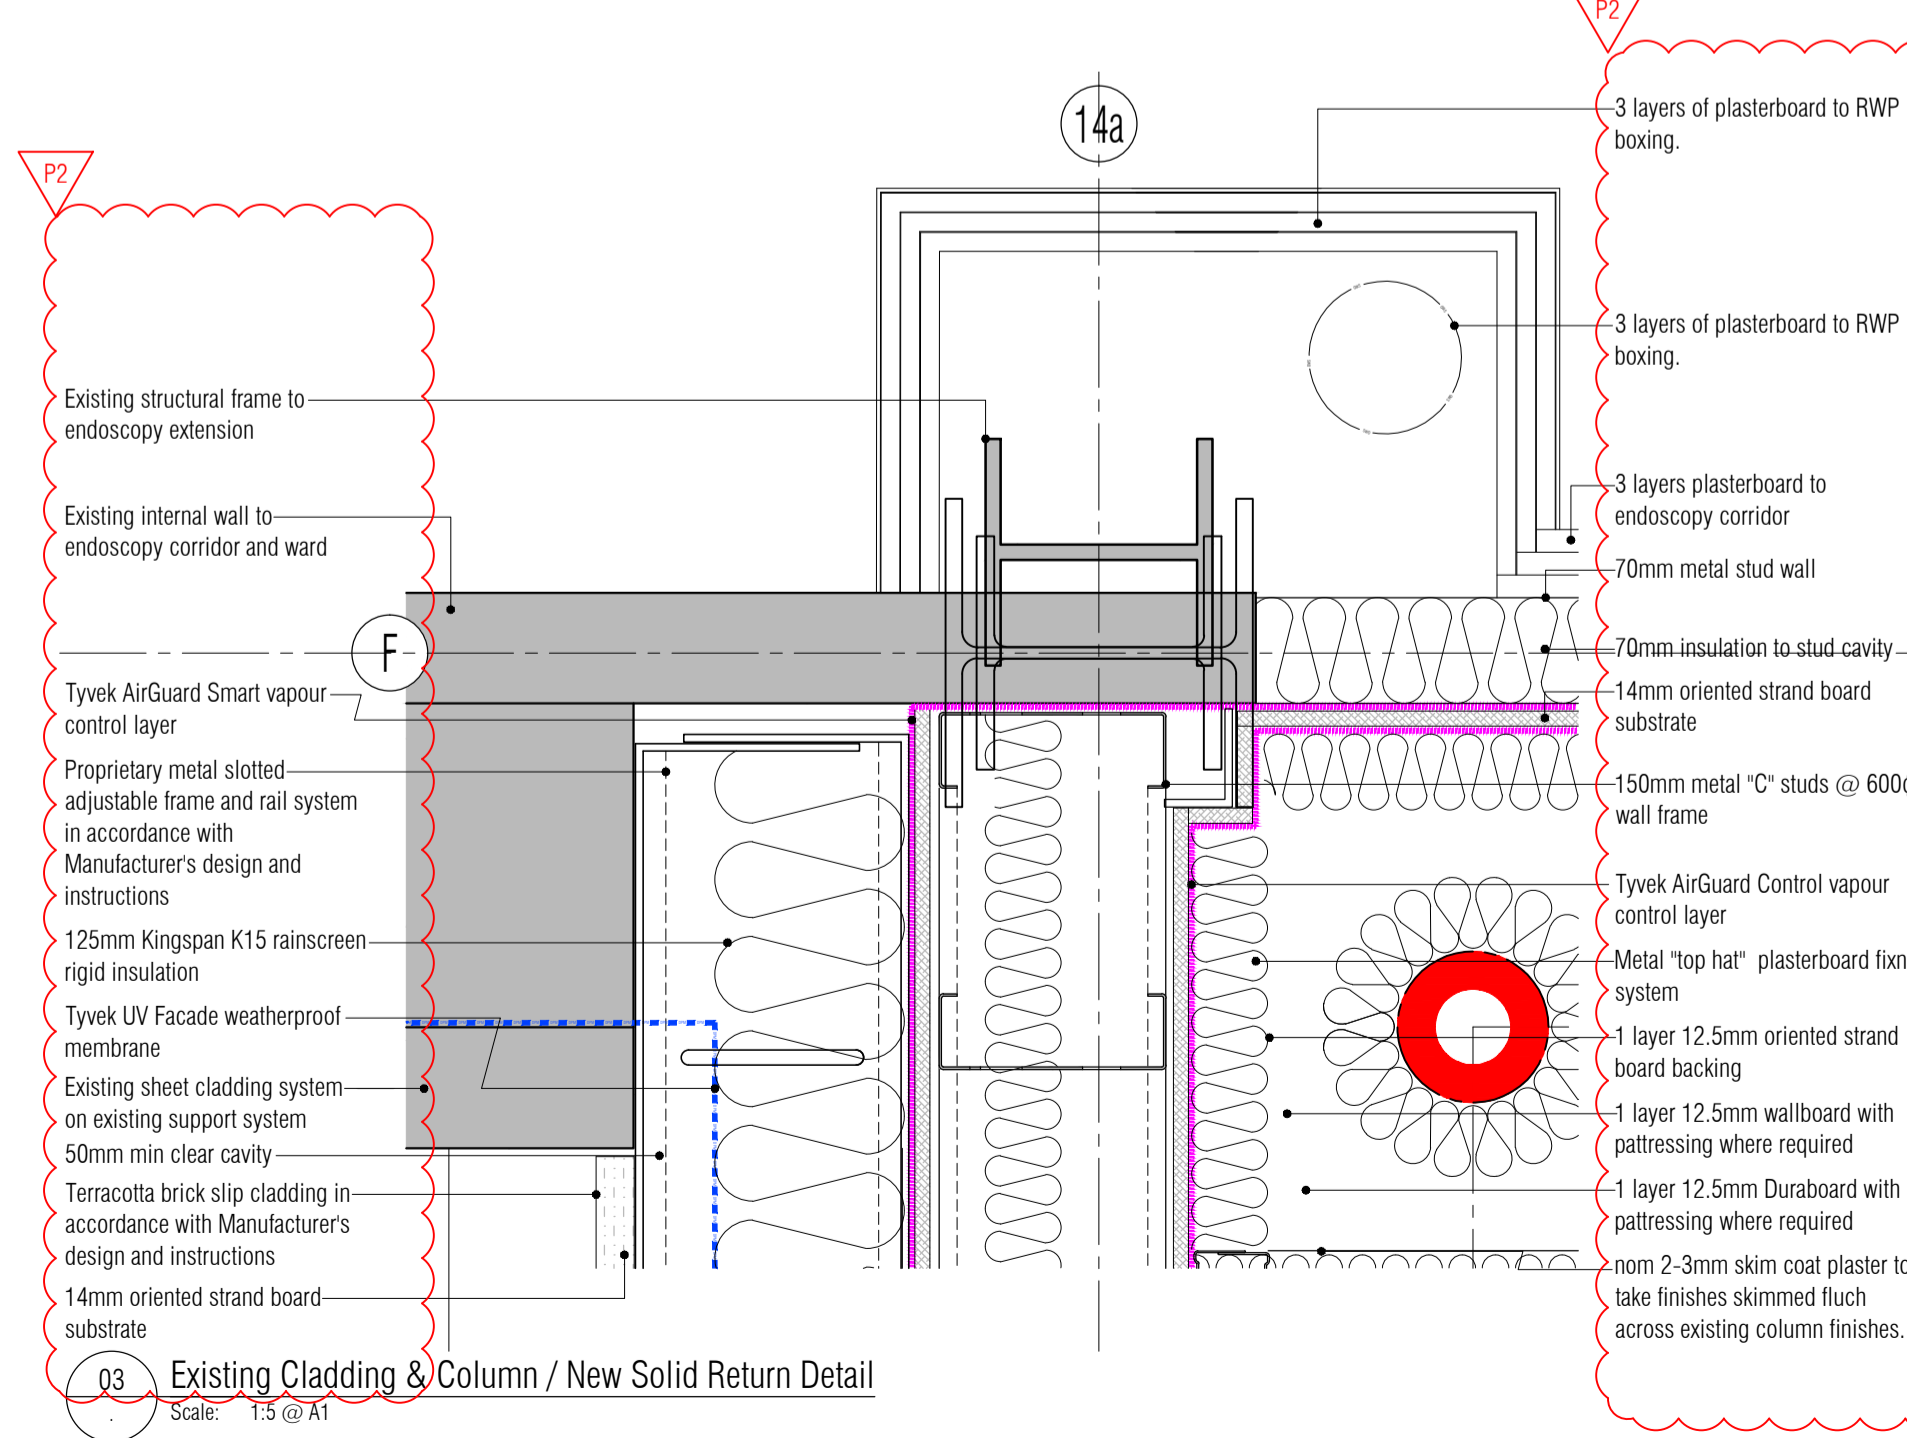


03 Existing Cladding & Column / New Solid Return Detail
Scale: 1:5 @ A1

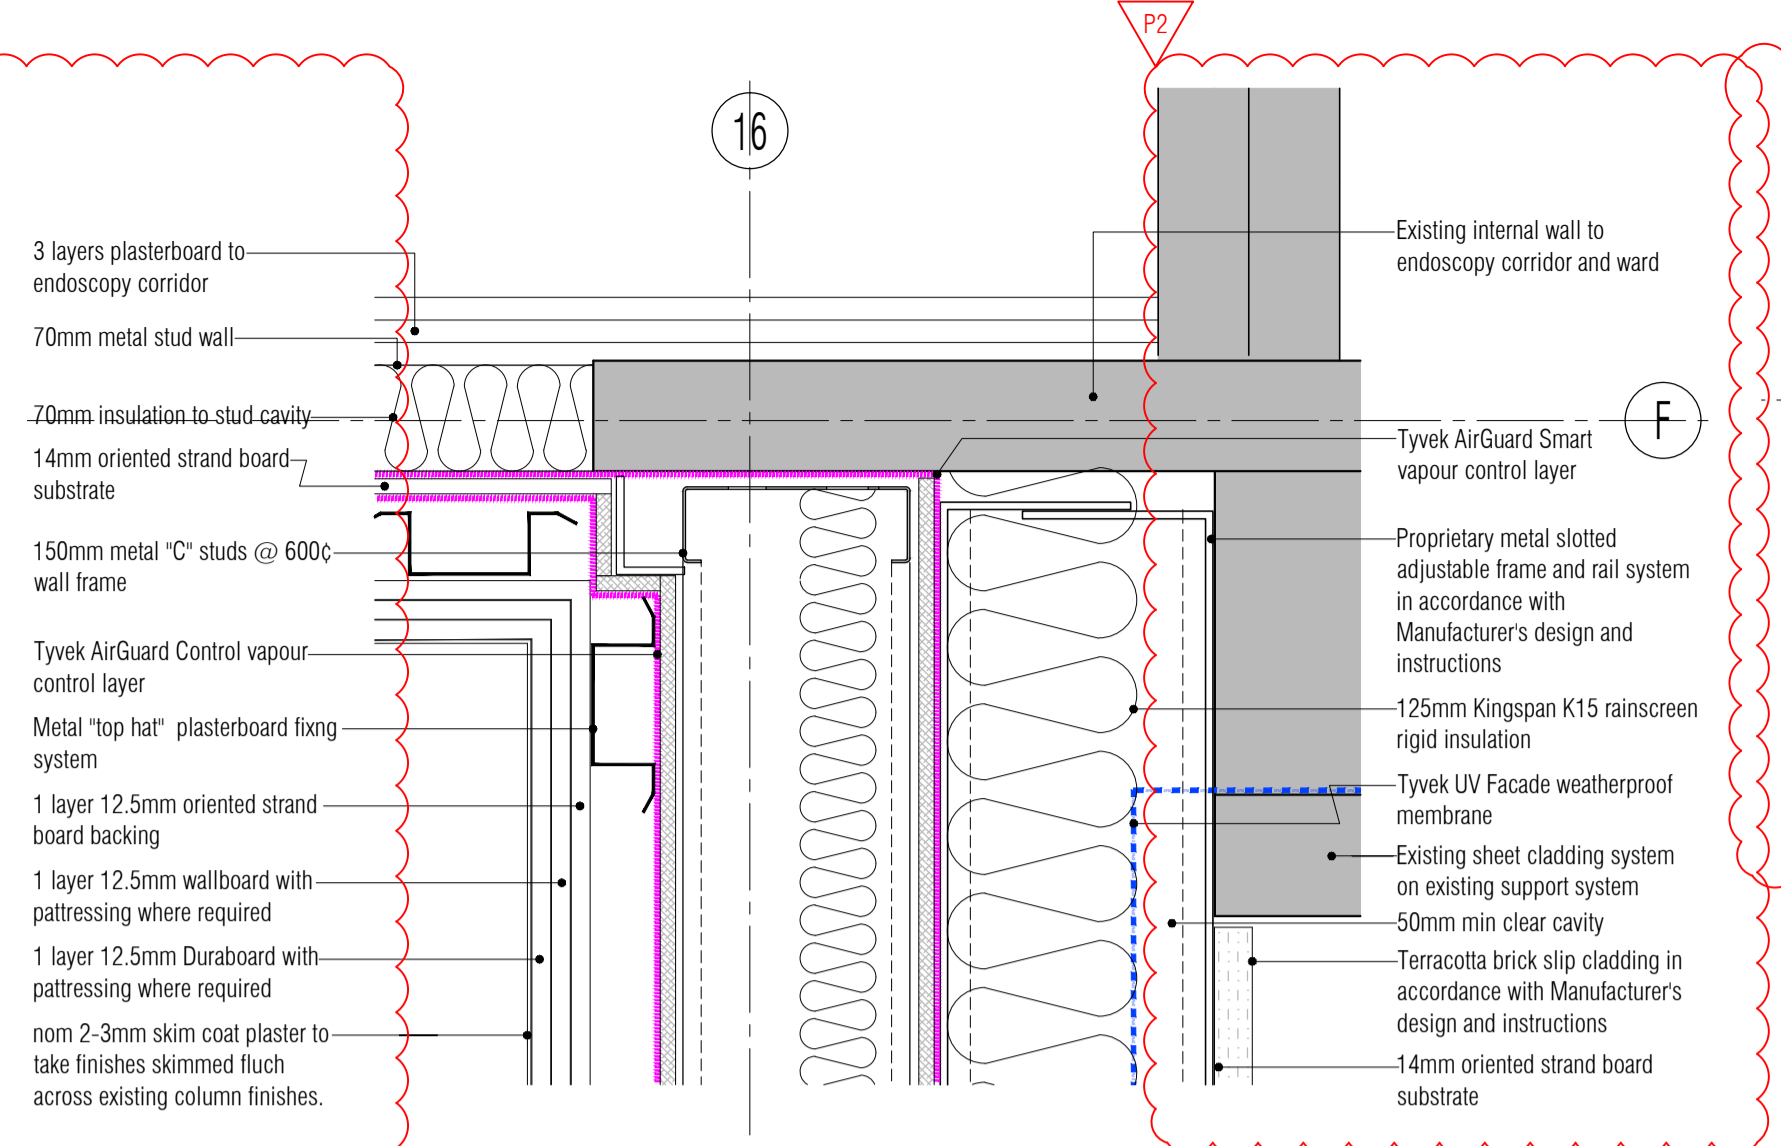


04 Existing Column Cladding / Solid Return Detail
Scale: 1:5 @ A1

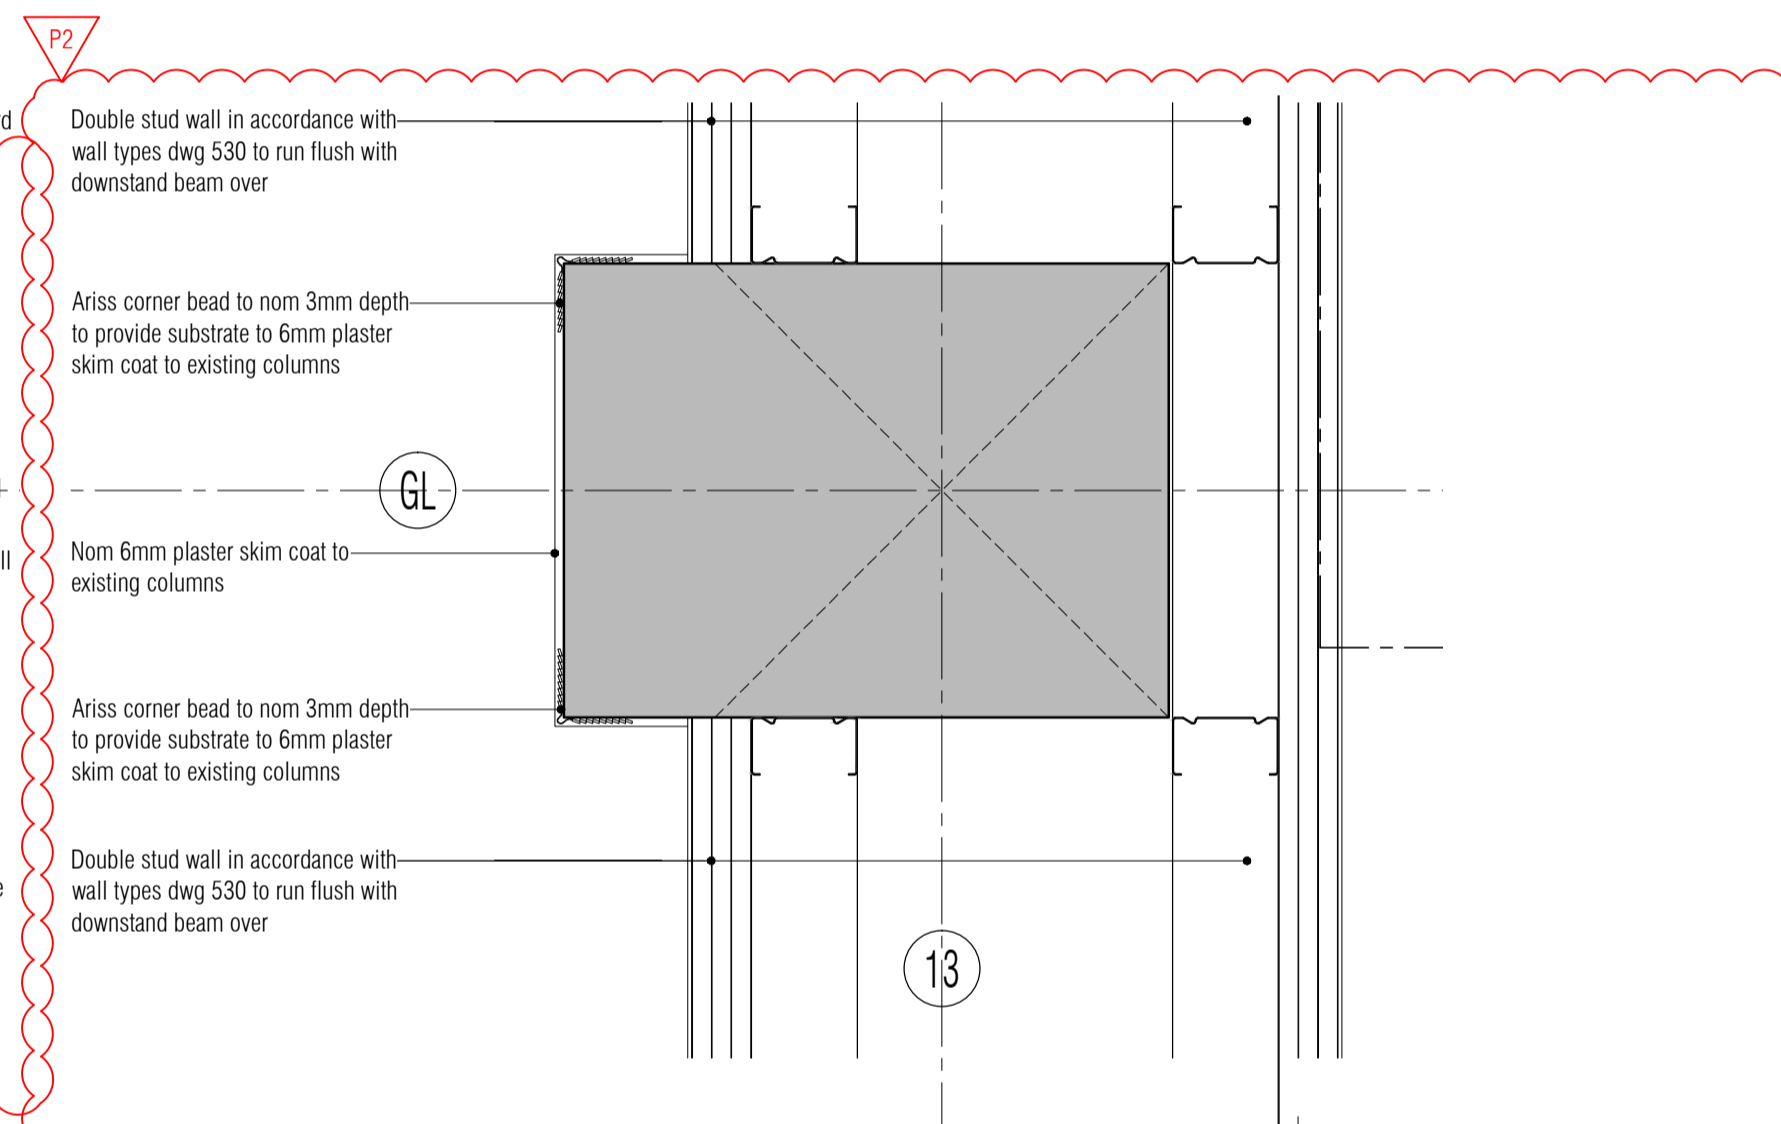


05 Existing Column Cladding / Flush Face Double Stud Wall Detail
Scale: 1:5 @ A1

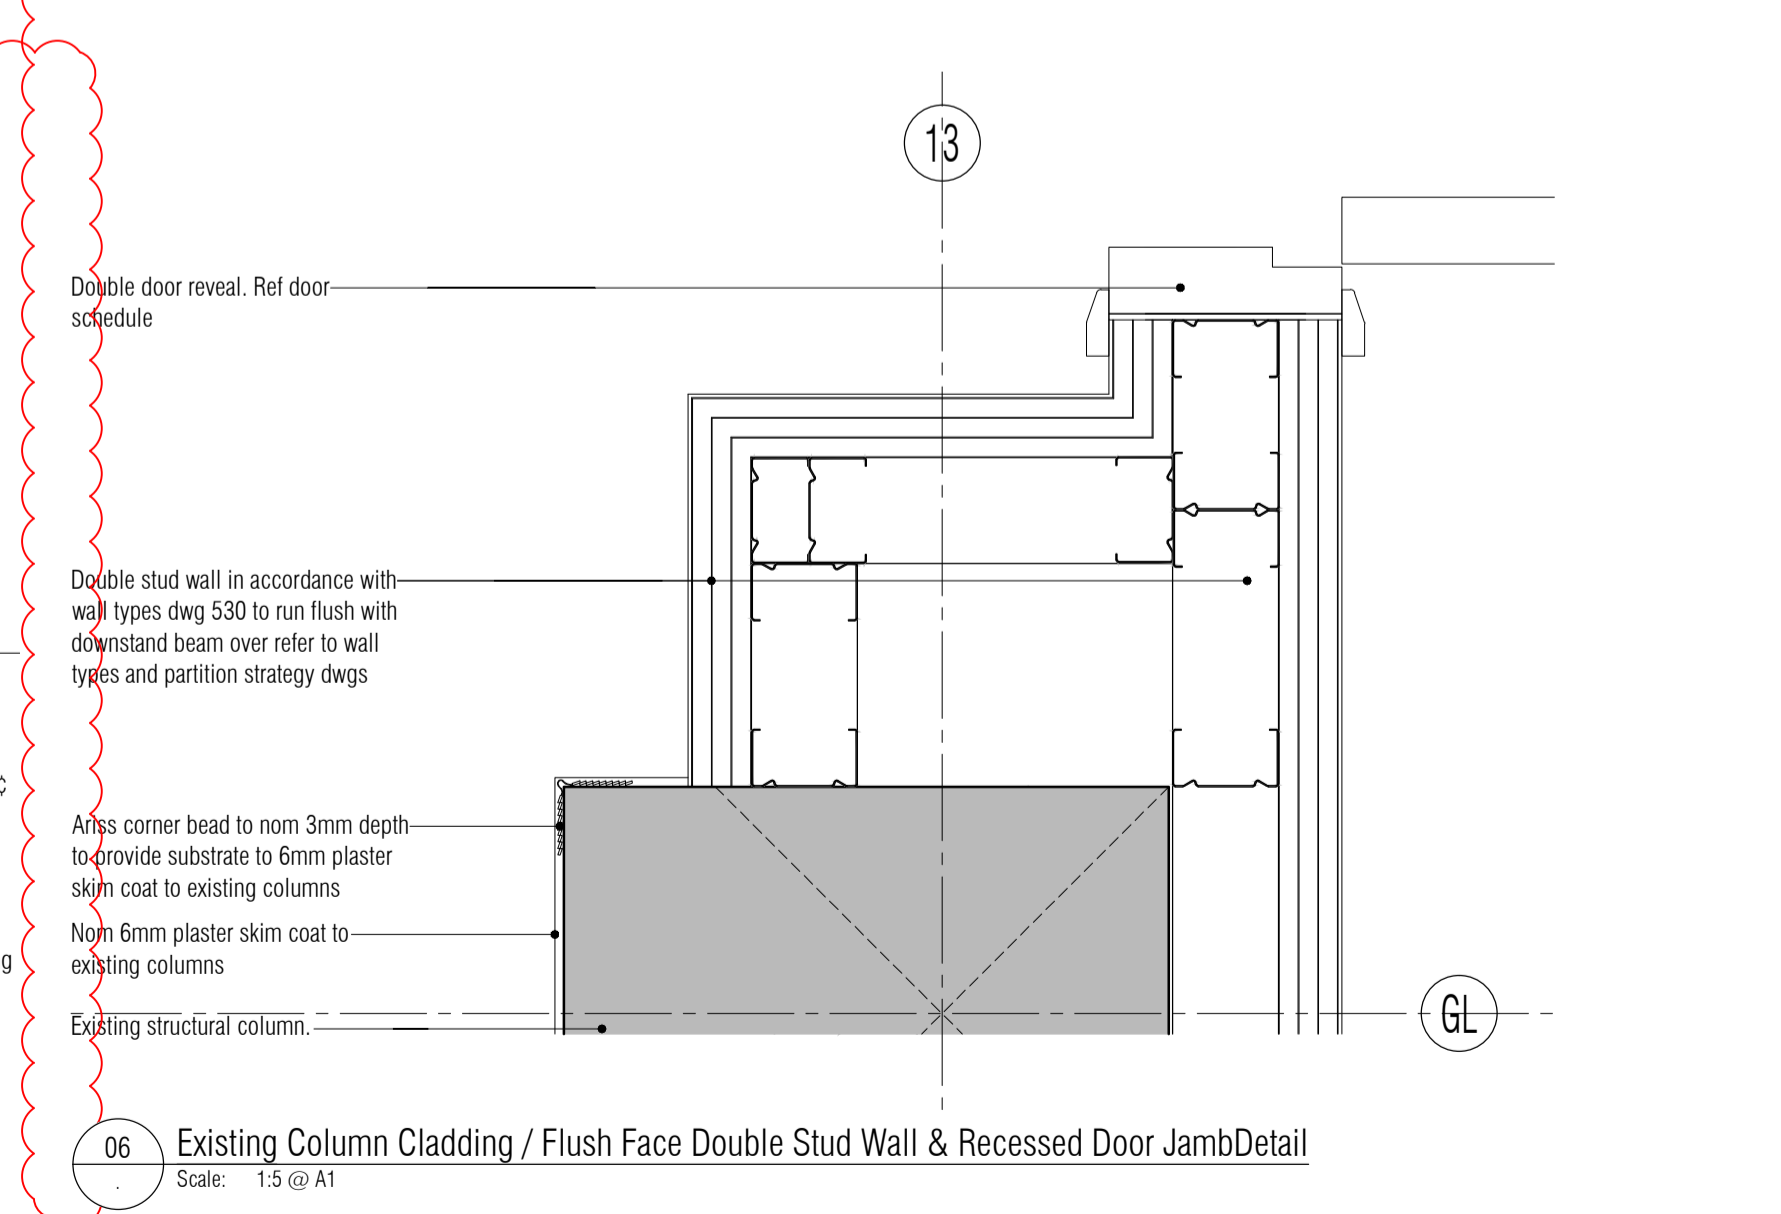

06 Existing Column Cladding / Flush Face Double Stud Wall & Recessed Door Jamb Detail
Scale: 1:5 @ A1

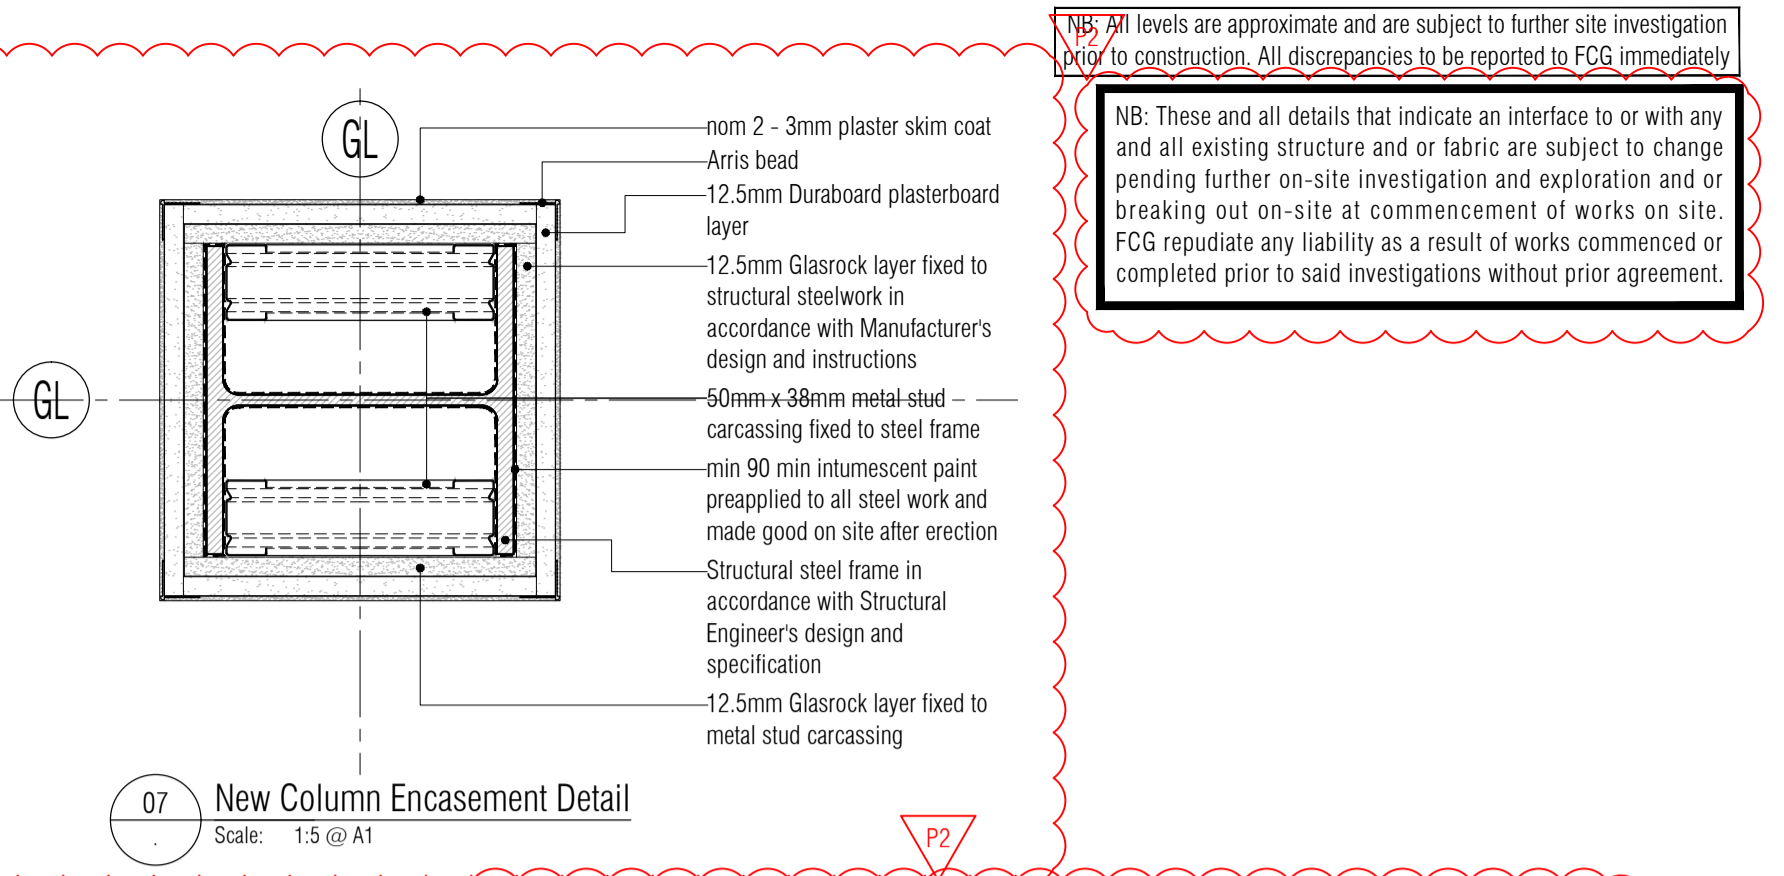

07 New Column Encasement Detail
Scale: 1:5 @ A1

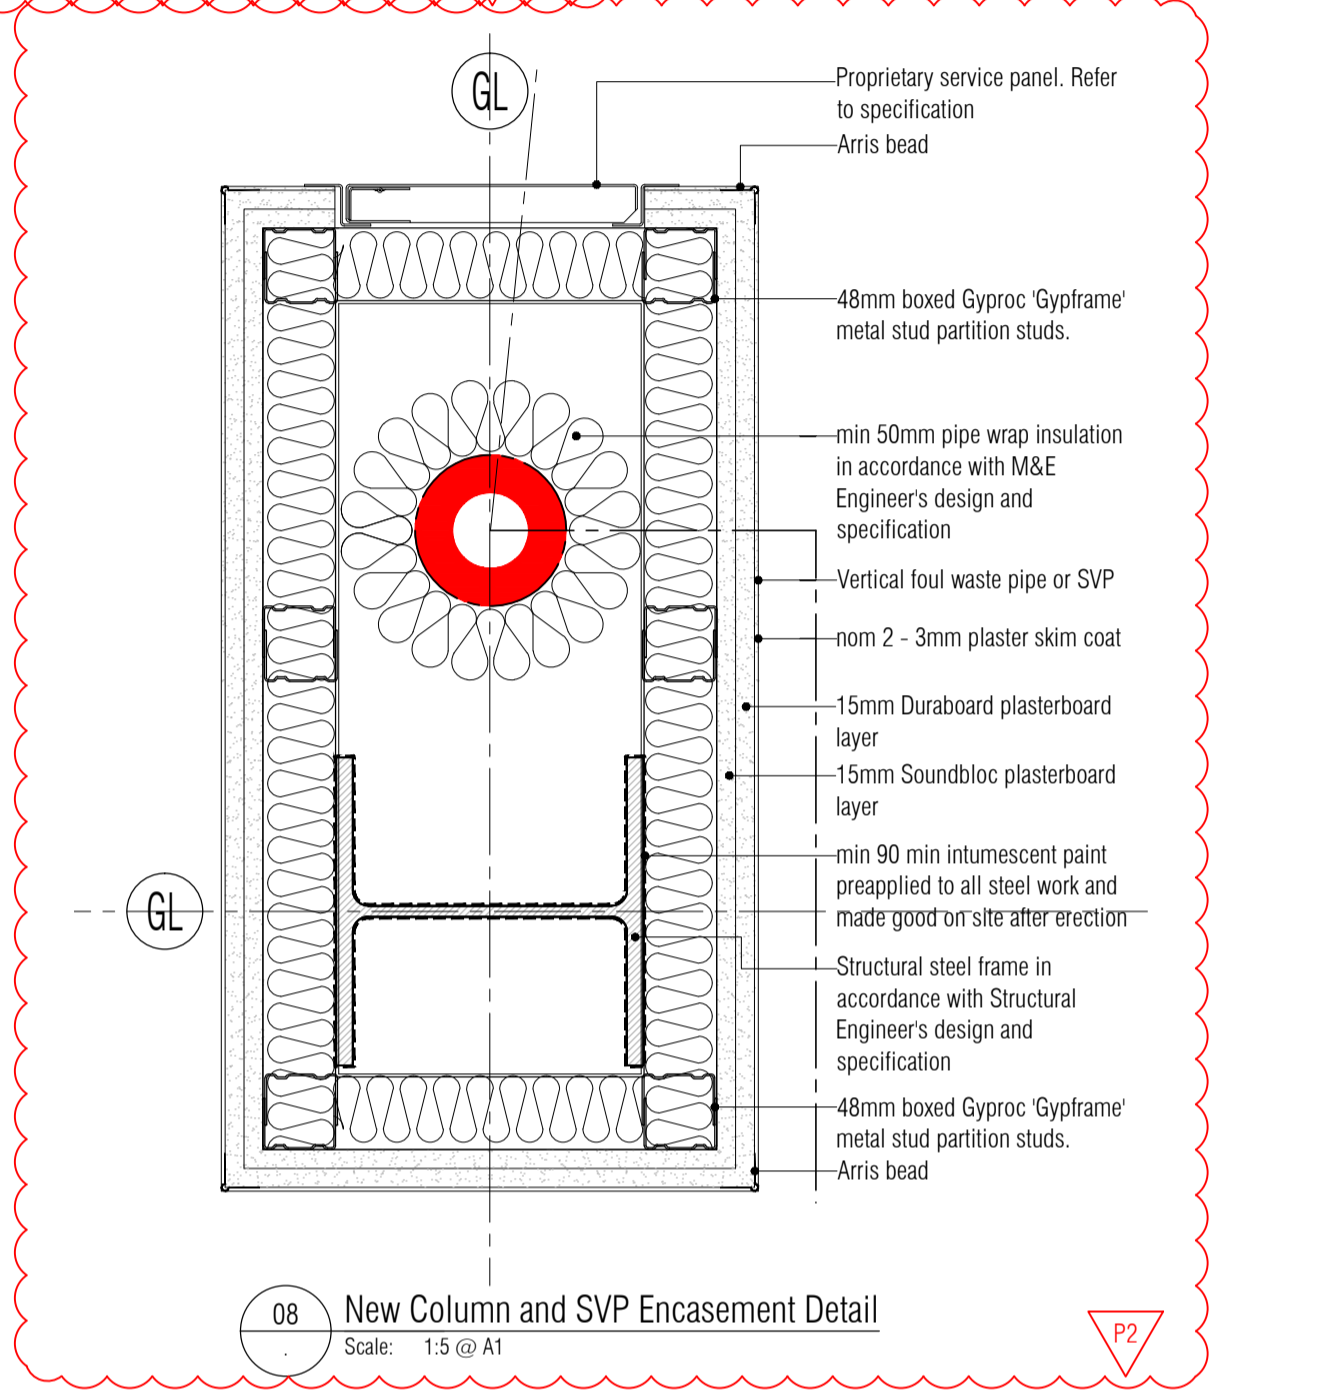


08 New Column and SVP Encasement Detail
Scale: 1:5 @ A1

NB: All levels are approximate and are subject to further site investigation prior to construction. All discrepancies to be reported to FCG immediately.

NB: These and all details that indicate an interface to or with any and all existing structure and or fabric are subject to change pending further on-site investigation and exploration and or breaking out on-site at commencement of works on site. FCG repudiate any liability as a result of works commenced or completed prior to said investigations without prior agreement.

NOTES: Do not scale this drawing. All dimensions to be checked on site prior to commencement or manufacture. Key Plan (nts)

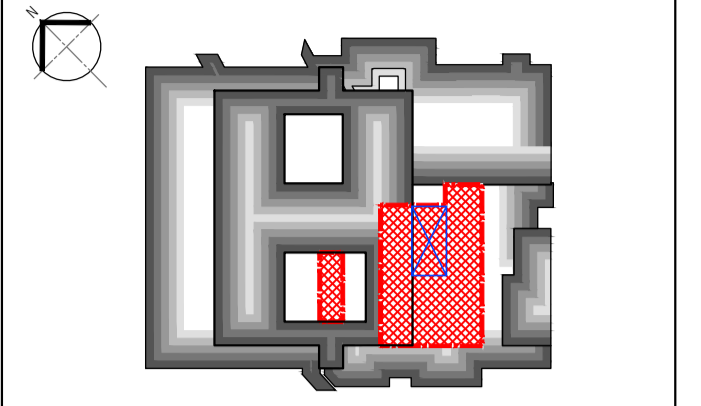

PRELIMINARY ISSUE

All details referenced in call outs supersede general arrangement or larger depictions.

Rev	Date	By	CHK	Comment
P2	04.11.14	JM	AGC	Gen revs
P1	22.11.13	JM	AGC	Preliminary Issue for Information

BRINGING IDEAS TO LIFE

FRANKHAM

Frankham Consultancy Group Limited
21 Perrymount Road
Haywards Heath, RH16 3TP
t 01444 444000 f 01444 455642
enquire@frankham.com
www.frankham.com

Client
St George's Healthcare NHS Trust

Project Title
General Intensive Care Unit Extension
St. James Wing
St. Georges Hospital
London

Drawing Title
Proposed
First Floor
Plan
Details

Drawn by: RKC	Scale: 1:10@A1	Date: 03.10.13
Designed by: FCG	Checked by: MDK	Approved by: AGC

File Ref: X:\FRANKHAM\2-2013\0111\02\ARCH\000-001-20131114-001.dwg - 2013/11/02 15:08:55

Drawing No:
521717-A-501

Rev:
P2

NB: All information based on supplied third party survey information. All discrepancies to be reported to FCG immediately upon discovery.

All Mechanical & Electrical and Structural information shown indicative only. Please refer to Mechanical & Electrical and Structural documentation.