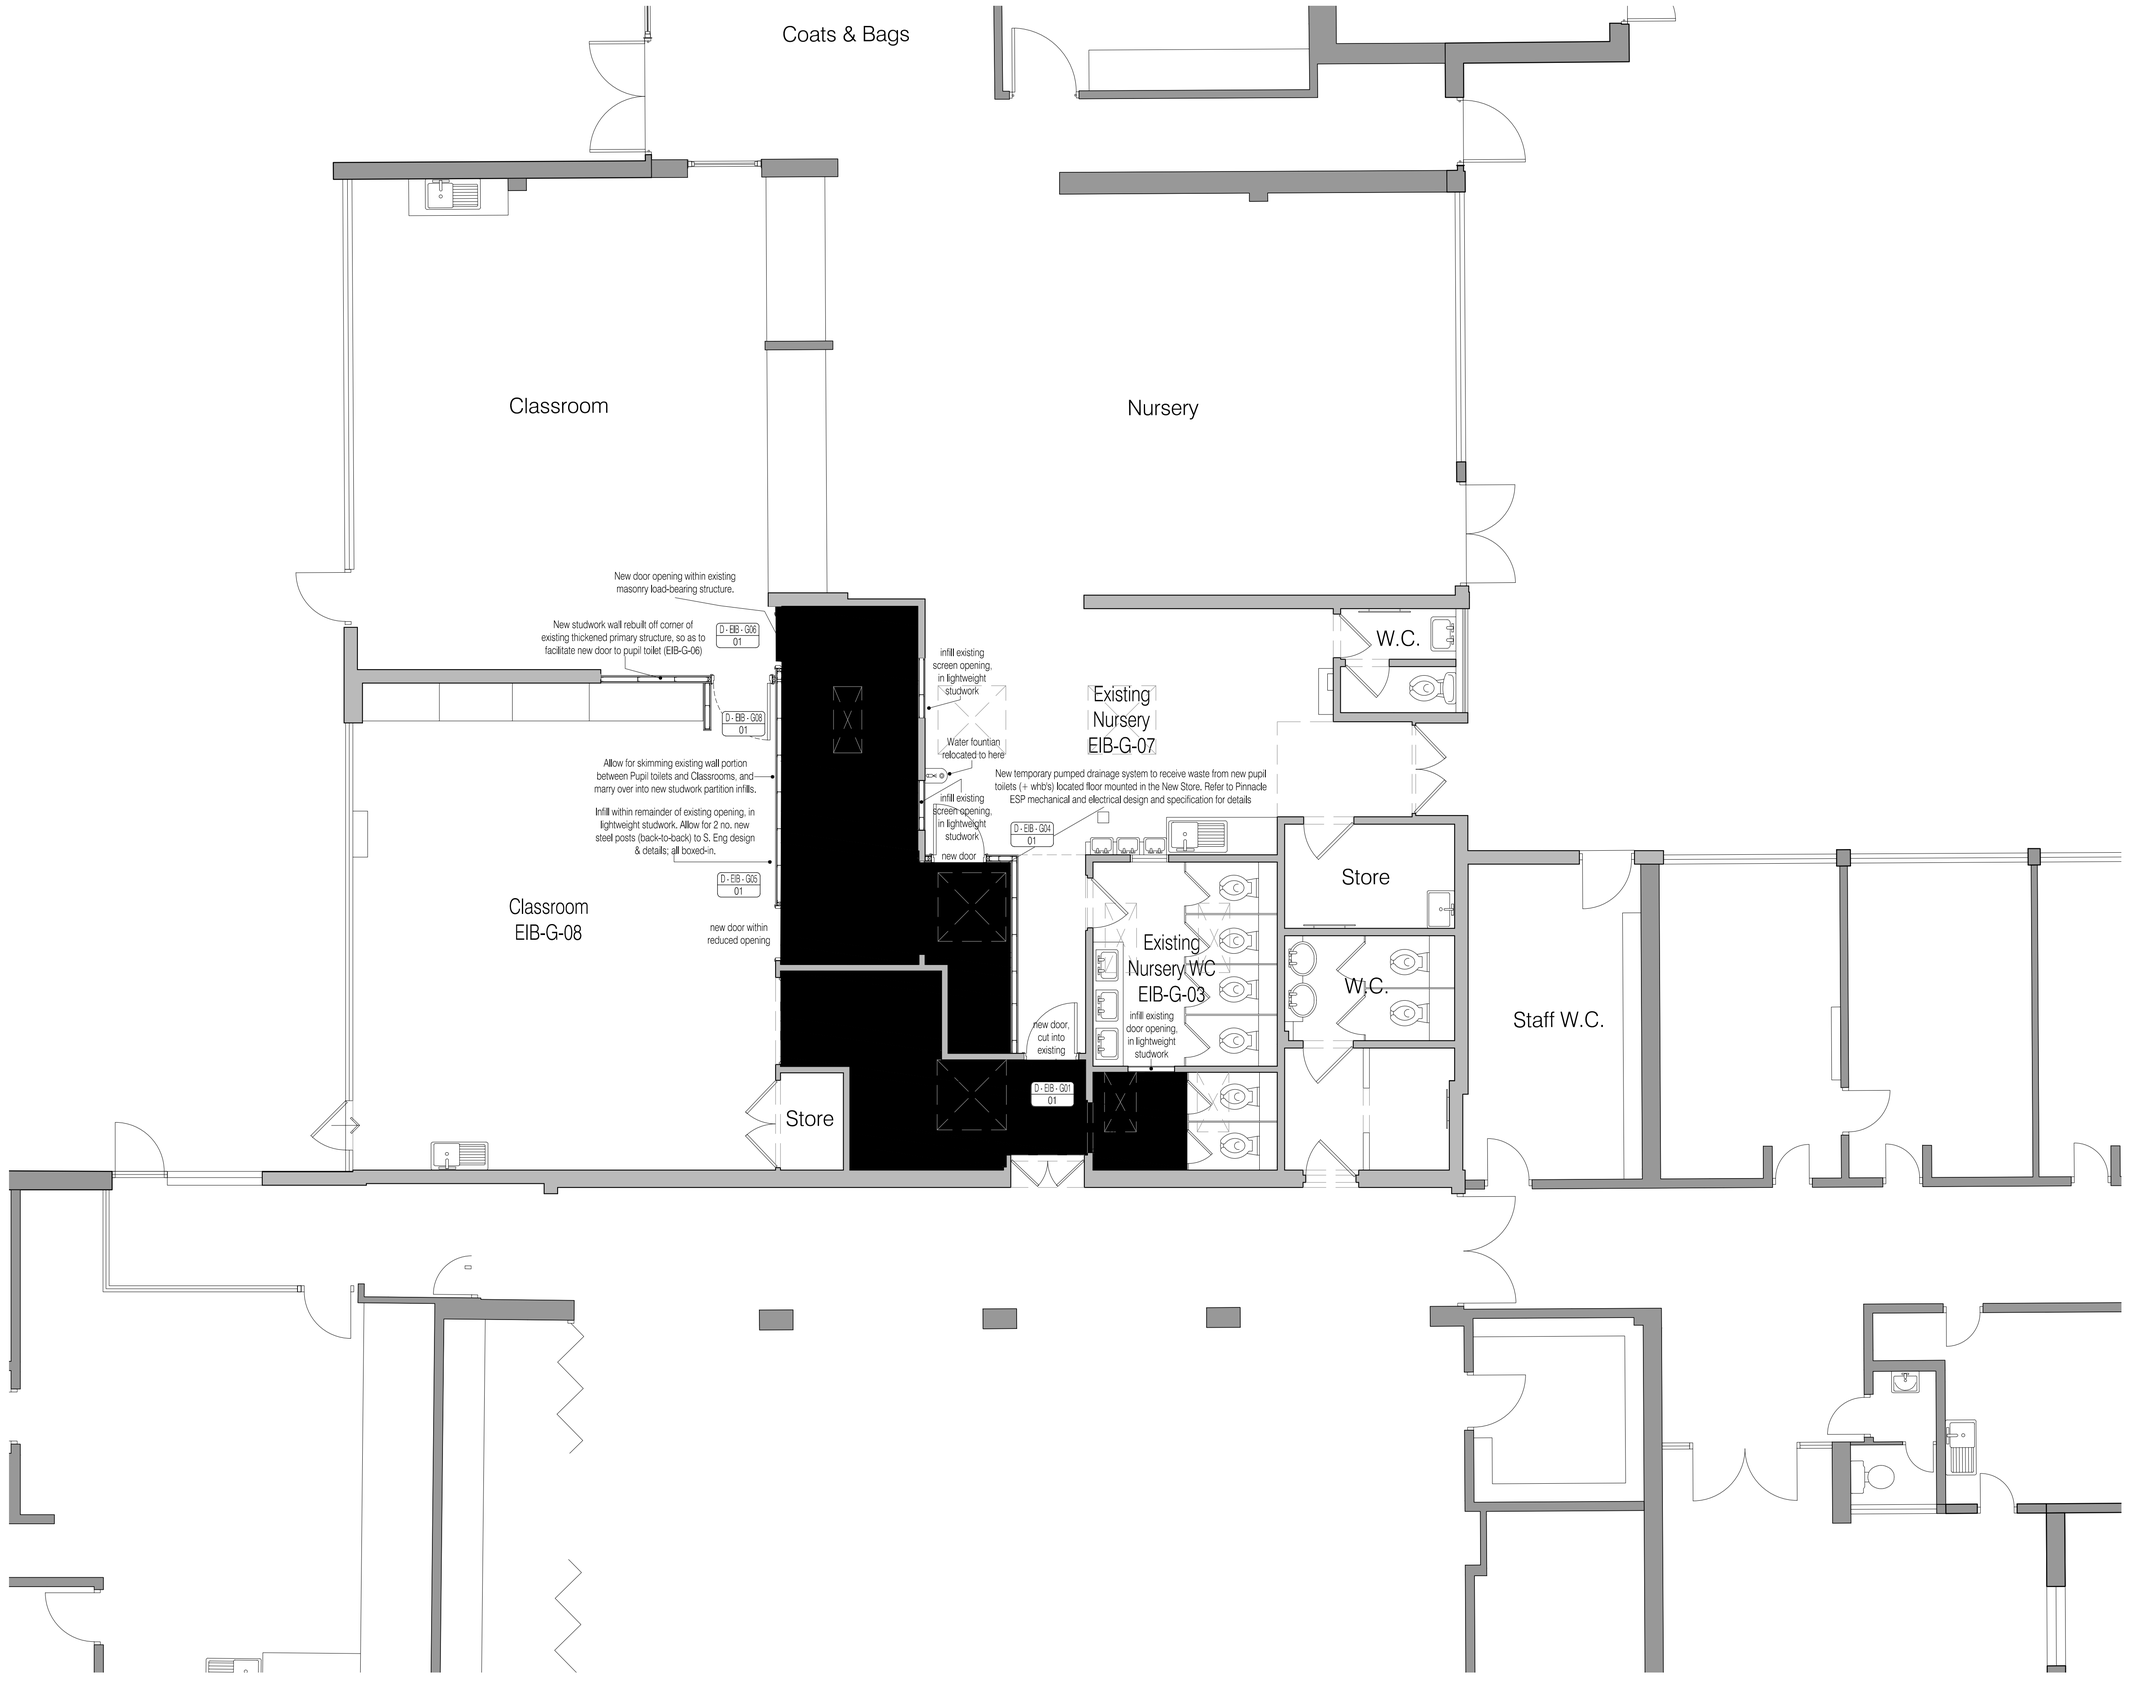

NOTES: Do not scale this drawing. All dimensions to be checked on site prior to commencement or manufacture.

NB: All information based on supplied third party survey information. All discrepancies to be reported to FCG immediately upon discovery.

AS BUILT DRAWING

Rev	Date	By	Chk	Comment
AB1	17.04.14	RKC	AGC	DRAWING ISSUED - AS BUILT

25 YEARS OF BRINGING IDEAS TO LIFE

FRANKHAM

Frankham Consultancy Group Limited
Frankham House Wootton Business Park
Besselsleigh Road Wootton Abingdon
Oxfordshire OX13 6FD
T 01865 322500 F 01865 327393
E enquire@frankham.com
www.frankham.com

ANNIVERSARY 25 YEARS 1982 - 2007

Client
Leadbitter CONSTRUCTION

Project Title
Whitehall Junior & Infant School
Refurbishment, Extension and New Build
Cowley Road
London Borough of Hillingdon

Drawing Title
Existing Infant School
Ground Floor Plan
Proposed Toilet Area Remodelling

Drawn by:	Scale:	Date:
RKC	1:50@A1	30.04.12
Designed by:	Checked by:	Approved by:
FCG	JAS	AC

File Ref.: X:\600000\611869 - HILLINGDON SCHOOLS - WHITEHALL REDESIGN\ARCH\100_199_LOCATION PLANS AND GA\611869-A-120.DWG - REV:AB1-14\04\2012\01 14.04.24 10:31:32

Drawing No.	Rev.
611869-A-120	AB1