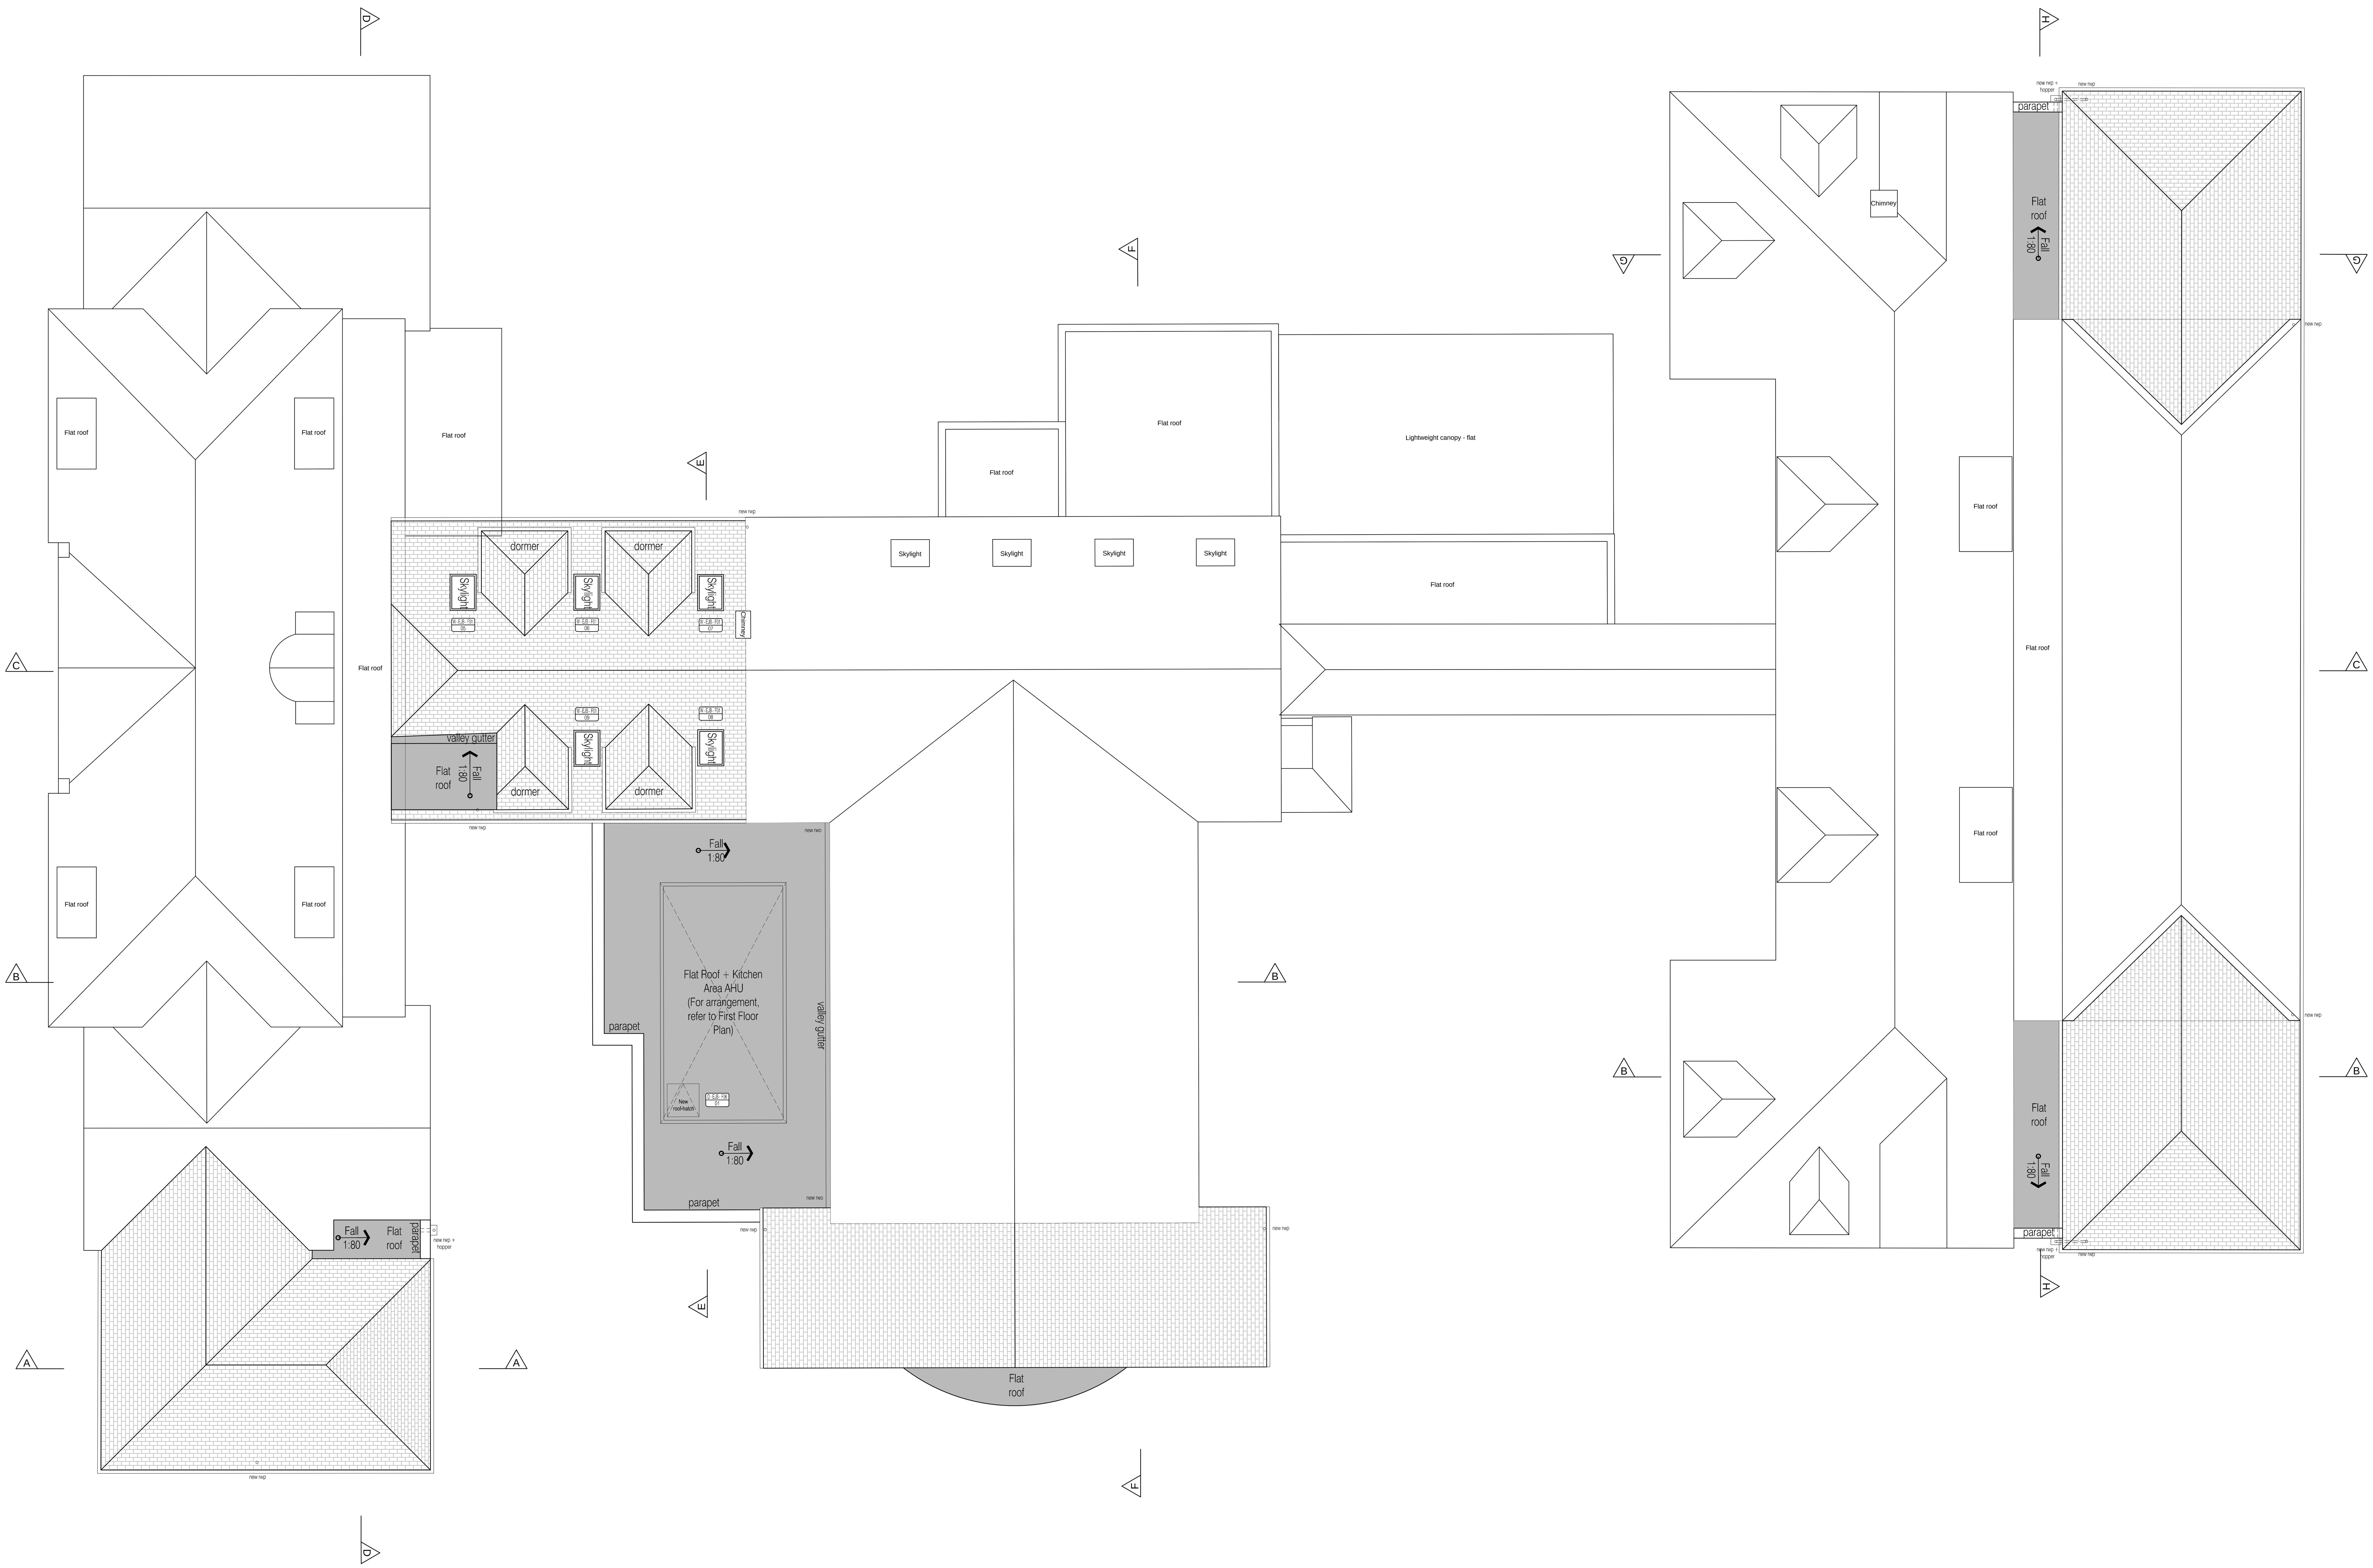

NOTES: Do not scale this drawing. All dimensions to be checked on site prior to commencement or manufacture.

NB: All information based on supplied third party survey information. All discrepancies to be reported to FCG immediately upon discovery.

Scale Bar

0 2 4 6 — 1:100

0 2 4 6 8 10 12 — 1:200

AS BUILT DRAWING

Rev	Date	By	Chk	Comment
AB1	17.04.14	RKC	AGC	DRAWING ISSUED - AS BUILT

25 YEARS OF BRINGING IDEAS TO LIFE

FRANKHAM

Frankham Consultancy Group Limited

ANNIVERSARY 25 YEARS 1982 - 2007

Frankham House Wootton Business Park
Besselsleigh Road Wootton Abingdon
Oxfordshire OX13 6FD
T 01865 322500 F 01865 327393
E enquire@frankham.com
www.frankham.com

Client
Leadbitter
CONSTRUCTION

Project Title
Whitehall Junior & Infant School
Refurbishment, Extension and New Build
Cowley Road
London Borough of Hillingdon

Drawing Title
Junior School
Proposed Roof Plan

Drawn by: RKC	Scale: 1:100@A1	Date: 11.05.12
Designed by: FCG	Checked by: JAS	Approved by: AC

File Ref.: X:\600000\611869 - HILLINGDON SCHOOLS - WHITEHALL REDESIGN\ARCH\100_199_LOCATION PLANS AND GA\611869-A-126.DWG - REV-AB1-140424103237 14:04:24:10:32:38

Drawing No. 611869-A-126 — Rev. AB1