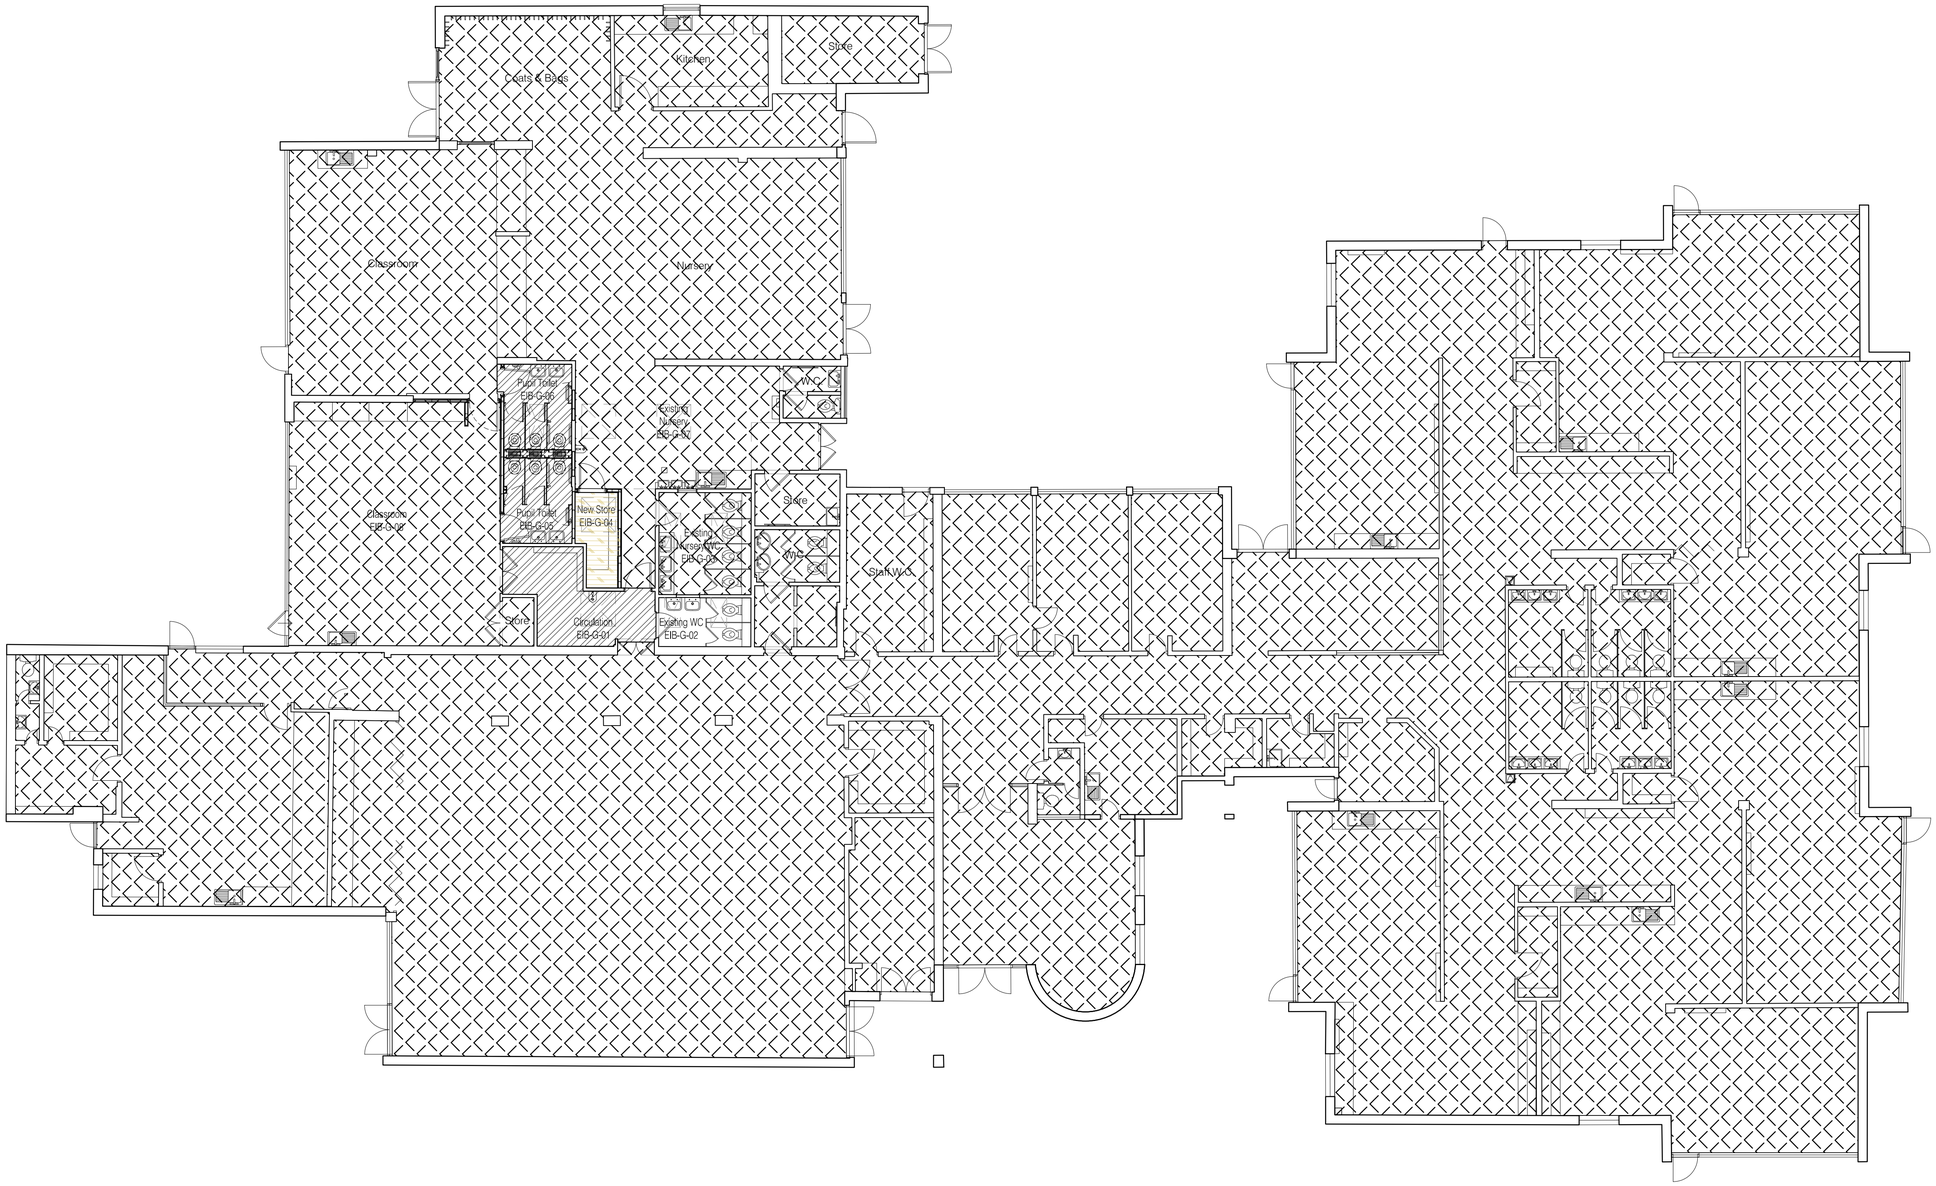


NOTES: Do not scale this drawing. All dimensions to be checked on site prior to commencement or manufacture.

NB: All information based on supplied third party survey information. All discrepancies to be reported to FCG immediately upon discovery.

Scale Bar

0 2 4 6 1:100

0 2 4 6 8 10 12 1:200

Floor Finishes Legend - Infants School

All colours to be confirmed. Similar hatch in adjacent rooms does not necessarily represent or signify same colour. All changes in floor finish type, floor finish colour, carpet colour, etc.

EXISTING — EXISTING FLOOR TO BE RETAINED.

ENTRANCE MATTING — M50/ HEAVY CONTRACT BROADLOOM CLEAN OFF CARPET TO ENTRANCE AREAS / EXTERNAL DOORS. MANUFACTURE & REFERENCE - HECKMONDWIKE BATTLESHIP. COLOUR: ANTHRACITE.

M50/ CARPETING TO CLASSROOMS AND GROUP ROOM. MANUFACTURE & REFERENCE - HECKMONDWIKE SUPACORD. COLOUR: PEBBLE.

VINYL — M50/ VINYL FLOORING WET PLAY AREAS AS INDICATED. MANUFACTURE & REFERENCE - GERFLOOR LTD. TARALAY INITIAL COMFORT. COLOUR: IMPACT 0542 COLZA.

CARPET — M50/ CARPETING TO CIRCULATION. MANUFACTURE & REFERENCE - HECKMONDWIKE SUPACORD. COLOUR: HEATHER.

HYGIENE VINYL — M50/ VINYL FLOORING TO WC AREAS. MANUFACTURE & REFERENCE - GERFLOOR LTD, TARASAFE STYLE / ULTRA. COLOUR: FIG. MAKE ALLOWANCE FOR COVED SKIRTING TO ALL WC / HYGIENE / CLEANER AREAS.

SEALER — M60/ CONCRETE FLOOR SEALER TO PLANT ROOM. MANUFACTURE & REFERENCE - WATCO LTD, UNIVERSAL SEALER.

VINYL — M50/ VINYL FLOORING TO STORES. MANUFACTURE & REFERENCE - GERFLOOR LTD. TARALAY INITIAL COMFORT. COLOUR: IMPACT CHAMOIS 0453.

VINYL STUDIO — M50/ VINYL FLOORING STUDIO. MANUFACTURE & REFERENCE - GERFLOOR LTD, TARAFLEX COMBISPORT SP28 AE UNDERCARRIAGE SYSTEM WITH TOP VINYL IN AN OAK FINISH.

KITCHEN TILE — M40/ TILED FLOORING TO STUDIO KITCHEN. MANUFACTURE & REFERENCE - JOHNSON KERASTAR - KER13 CRONOS. SURFACE - DISCFACE, 300 x 300 x 8.5MM. ACCOUNT FOR CURVED TILE 300 x 100 x 8.5mm COVE SKIRTING TO ALL WALL INTERFACES INCLUDING INTERNAL AND EXTERNAL ANGLES.

FLOOR FINISHES TO BE LAID UNDER ALL BASE UNITS.

JOINT BETWEEN UNITS OR SKIRTING TO BE SEALED WITH WHITE SILICONE SEALANT ON VINYL FLOORS.

JUCTION BETWEEN CARPET AND VINYL FLOOR FINISH TO HAVE ALUMINIUM COVER STRIPS.

AS BUILT DRAWING

| Rev | Date | By | Chk | Comment |
|---|---|---|---|---|
| AB1 | 17.04.14 | RKC | AGC | DRAWING ISSUED - AS BUILT |


25 YEARS OF BRINGING IDEAS TO LIFE

FRANKHAM

Frankham Consultancy Group Limited
Frankham House Wootton Business Park
Besselsleigh Road Wootton Abingdon
Oxfordshire OX13 6FD
T 01865 322500 F 01865 327393
E enquire@frankham.com
www.frankham.com


25 ANNIVERSARY 1982 - 2007

Client: Leadbitter CONSTRUCTION

Project Title: Whitehall Junior & Infant School
Refurbishment, Extension and New Build
Cowley Road
London Borough of Hillingdon

Drawing Title: Infants School WC Area
Proposed Ground Floor Plan
Floor Finishes Legend

| Drawn by: | Scale: | Date: |
|---|---|---|
| RKC | 1:100@A1 | 30.05.12 |
| Designed by: | Checked by: | Approved by: |
| FCG | JAS | AC |

File Ref: X:\0000\041\1800-HILLINGDON SCHOOLS - WHITEHALL REDESIGN\ARCH\100_ISL_LOCATION PLANS AND GA\611869-A-140ZW3 - REVAB1-140424103340 14:04:24:10:33:44

| Drawing No. | Rev. |
|---|---|
| 611869-A-140 | AB1 |