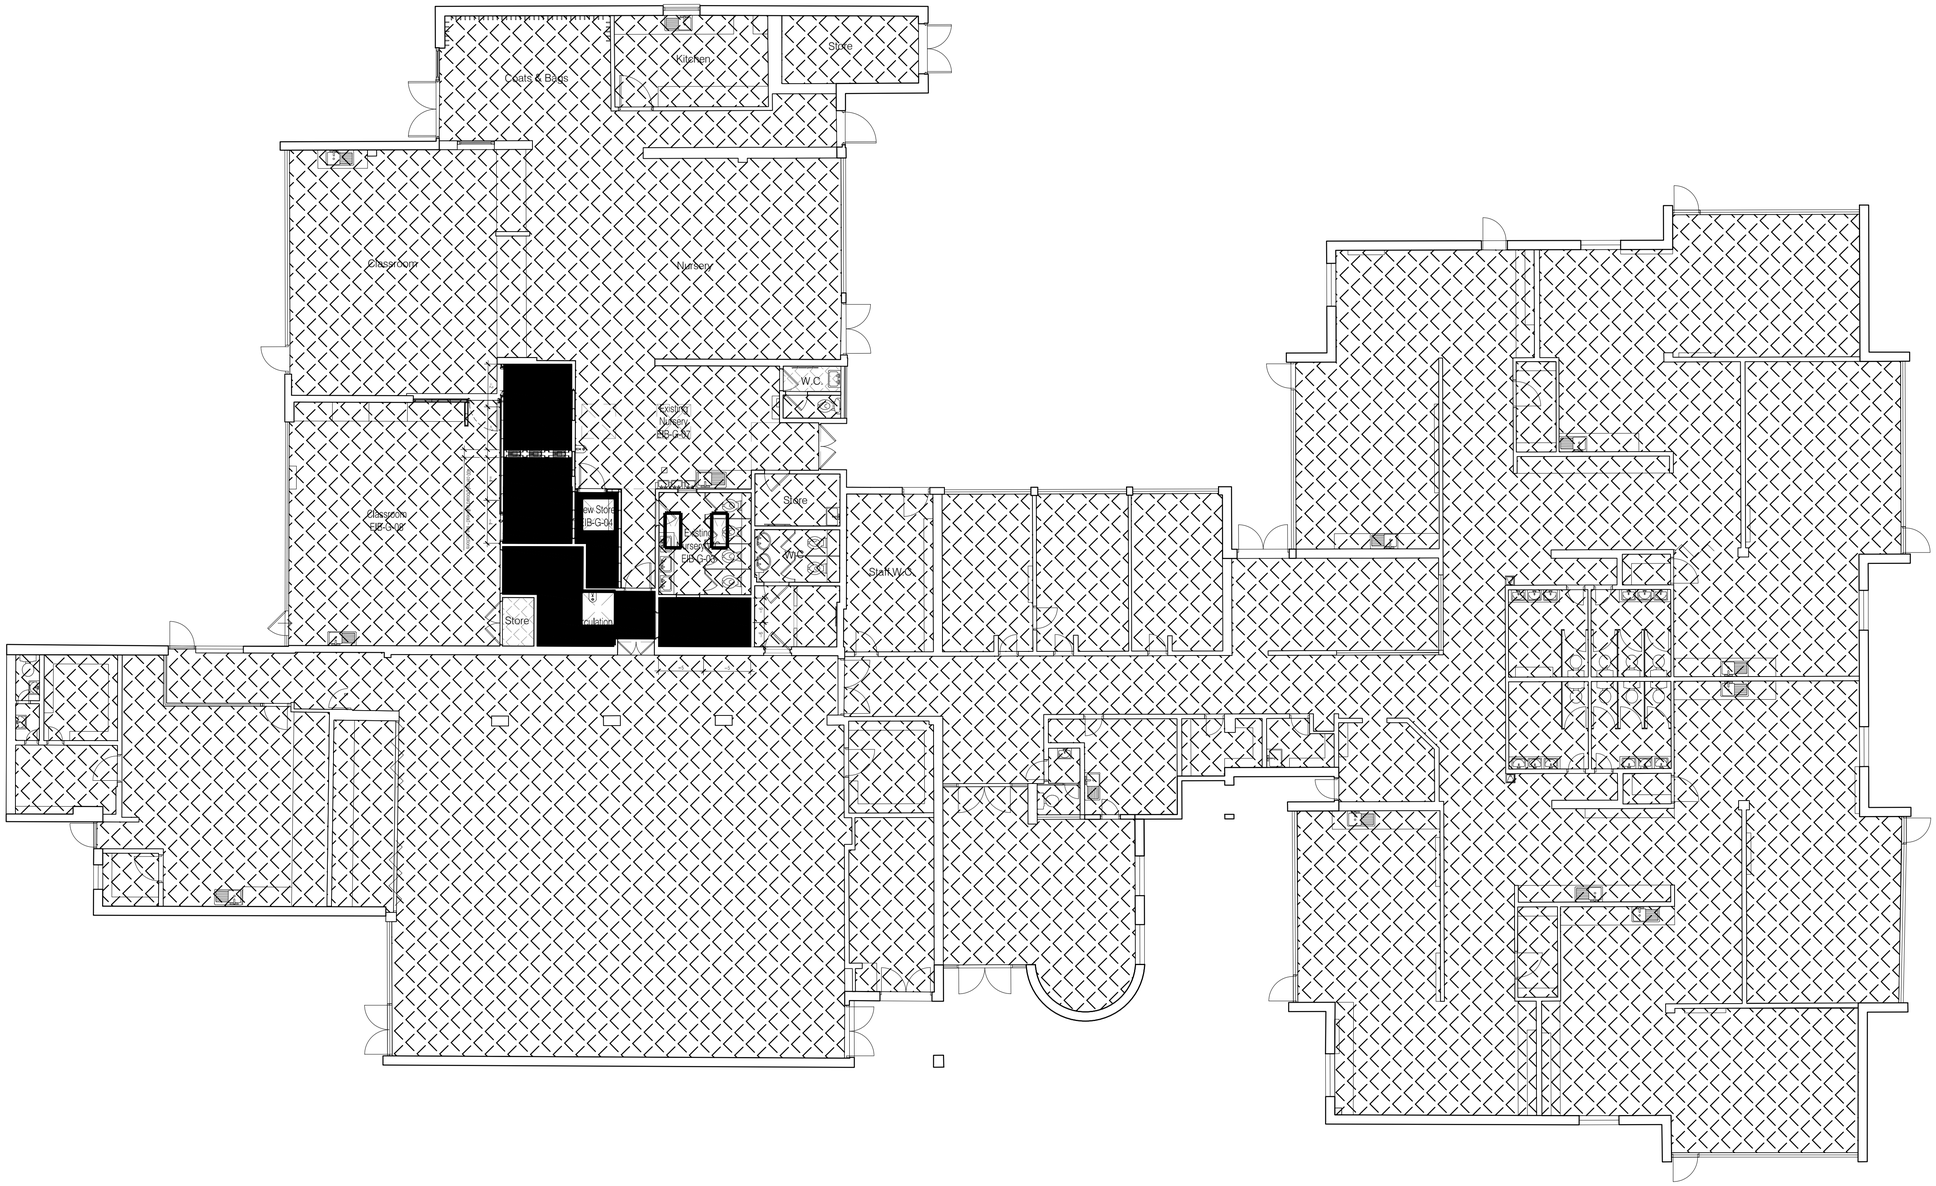

NOTES: Do not scale this drawing. All dimensions to be checked on site prior to commencement or manufacture.

NB: All information based on supplied third party survey information. All discrepancies to be reported to FCG immediately upon discovery.

Scale Bar

0 2 4 6 1:100

0 2 4 6 8 10 12 1:200

Reflected Ceiling Plan Legend - Infants School

All colours to be confirmed.

- Plasterboard bulkhead with downlighters
- Suspended Ceiling 600x600 Grid
- Kitchen Cold Room Ceiling
- Plasterboard Ceiling
- Existing Ceiling
- Extent of Shadow Gap to Rooms
- Extent of Line of Bulkhead to Voids & Rooflights
- Centre Line of Room for Ceiling Tile Setting Out

AS BUILT DRAWING

Rev	Date	By	Chk	Comment
AB1	17.04.14	RKC	AGC	DRAWING ISSUED - AS BUILT

25 YEARS OF BRINGING IDEAS TO LIFE

FRANKHAM

Frankham Consultancy Group Limited

Frankham House Wootton Business Park
Besselsleigh Road Wootton Abingdon
Oxfordshire OX13 6FD

T: 01865 322500 F: 01865 327393
E: enquire@frankham.com
www.frankham.com

25 ANNIVERSARY 25 YEARS 1982 - 2007

Client: Leadbitter CONSTRUCTION

Project Title: Whitehall Junior & Infant School
Refurbishment, Extension and New Build
Cowley Road
London Borough of Hillingdon

Drawing Title: Infants School WC Area
Proposed Ground Floor
Reflected Ceiling Plan

Drawn by:	Scale:	Date:
RKC	1:100@A1	30.05.12
Designed by:	Checked by:	Approved by:
FCG	JAS	AC

File Ref.: X:\600000\611869 - HILLINGDON SCHOOLS - WHITEHALL REDESIGN\ARCH\100_19B_LOCATION PLANS AND GA\611869-A-150.DWG - REV:AB1-14/04/2014 14:04:24:10:34:17

Drawing No.	Rev.
611869-A-150	AB1