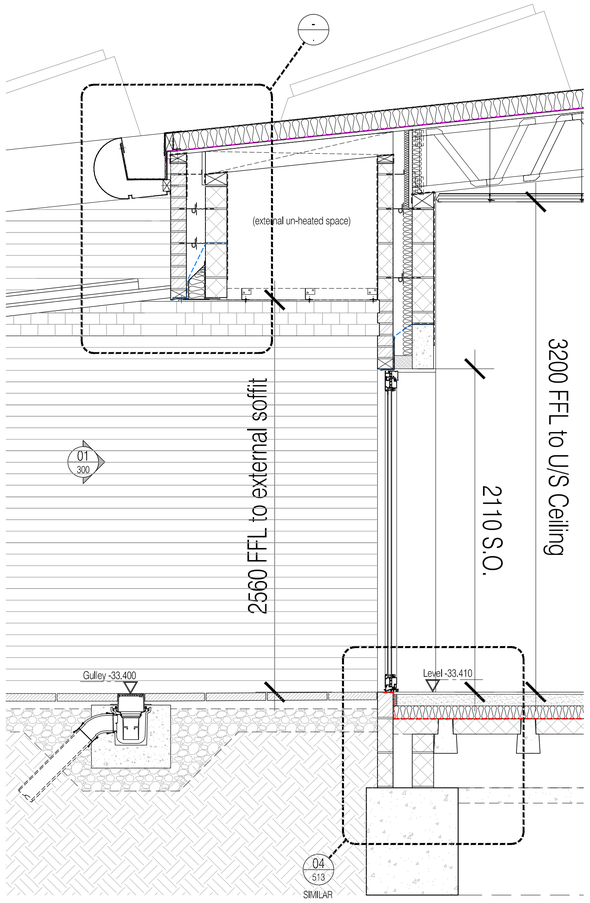

01 Section 4
Scale: 1:20

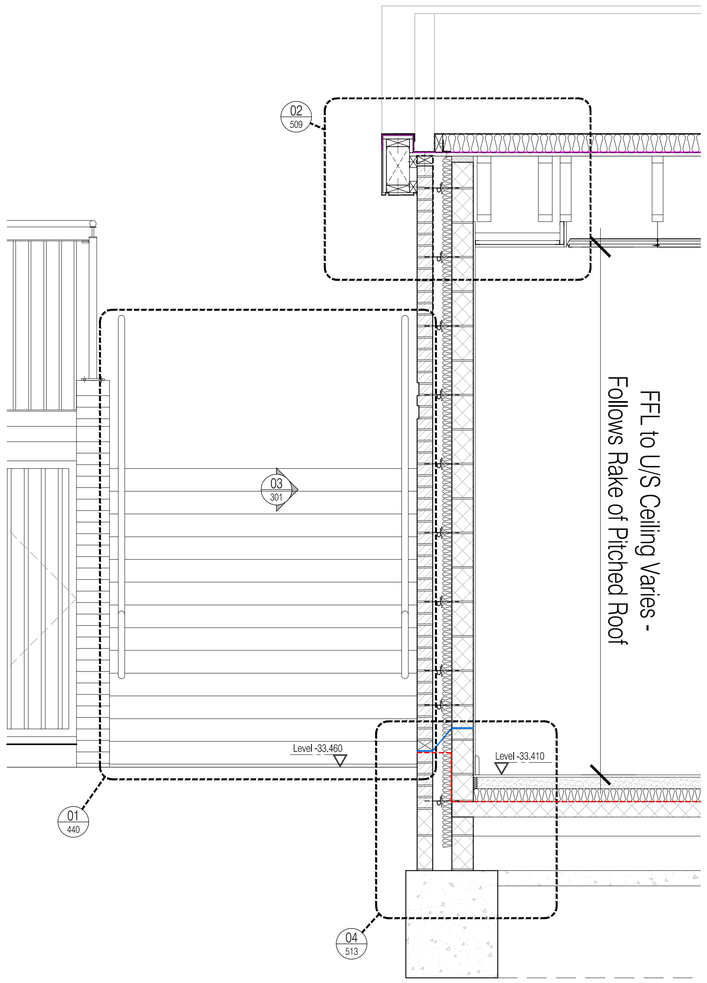

02 Section 5
Scale: 1:20

NOTES: Do not scale this drawing. All dimensions to be checked on site prior to commencement or manufacture.

AS BUILT DRAWING

Rev	Date	By	Chk	Comment
AB1	17.04.14	RKC	AGC	DRAWING ISSUED - AS BUILT

25 YEARS OF BRINGING IDEAS TO LIFE

FRANKHAM

Frankham Consultancy Group Limited
Frankham House Wootton Business Park
Besselsleigh Road Wootton Abingdon
Oxfordshire OX13 6FD
T **01865 322500** F **01865 327393**
E **enquire@frankham.com**
www.frankham.com

25 ANNIVERSARY 1982 - 2007

Client
Leadbitter CONSTRUCTION

Project Title
Whitehall Junior & Infant School
Refurbishment, Extension and New Build
Cowley Road
London Borough of Hillingdon

Drawing Title
New Infant Block
Proposed Wall Strip Sections
(Sheet 2)

Drawn by:	Scale:	Date:
RKC	1:20@A1	03.10.12
Designed by:	Checked by:	Approved by:
FCG	JAS	AC

File Ref.: X:\000000611869 - HILLINGDON SCHOOLS - WHITEHALL REDESIGN\ARCH\20_3M_SECTION\S 14.04.24 10:42:39

Drawing No. 611869-A-235
Rev. AB1