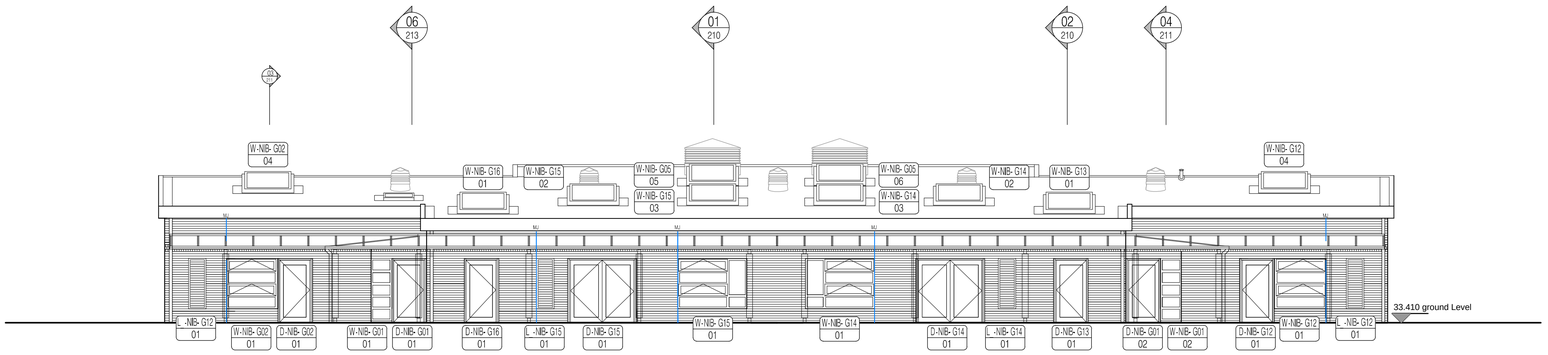

01 West Facing Elevation
Scale: 1:100

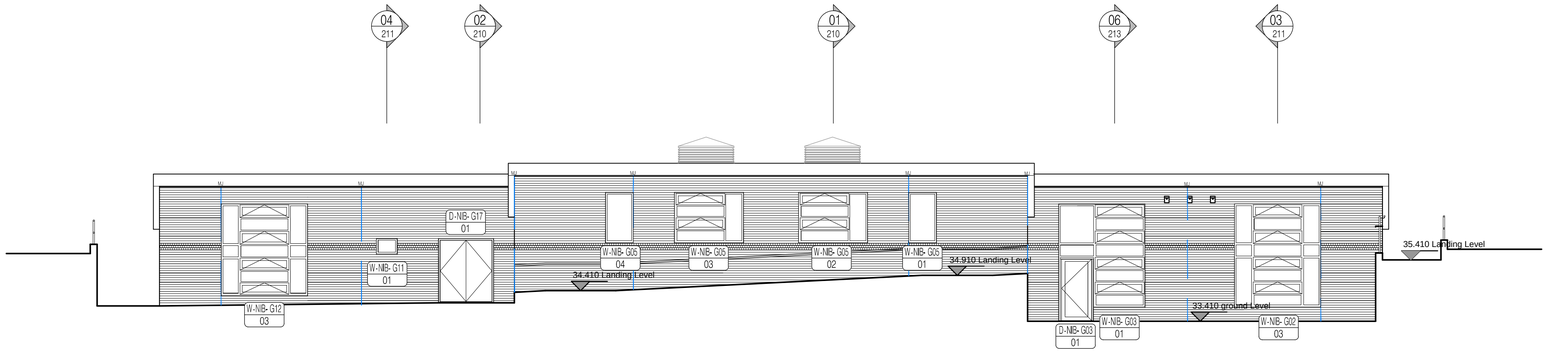

02 East Facing Elevation
Scale: 1:100

NOTES: Do not scale this drawing. All dimensions to be checked on site prior to commencement or manufacture.

Bat Boxes:
- M&E Subcontractor to review position of lighting to allow 4m distance from Bat Boxes.

Bird Boxes:
- Hole size to be confirmed by School - dependant on bird species to be attracted.

FOR SETTING OUT OF BIRD AND BAT BOXES, REFER TO DRAWING NUMBER 611869-A-131 and 132

AS BUILT DRAWING

Rev	Date	By	Chk	Comment
-	-	-	-	-
-	-	-	-	-
-	-	-	-	-
-	-	-	-	-
-	-	-	-	-
-	-	-	-	-

25 YEARS OF BRINGING IDEAS TO LIFE

FRANKHAM

Frankham Consultancy Group Limited
Frankham House Wootton Business Park
Besselsleigh Road Wootton Abingdon
Oxfordshire OX13 6FD
T **01865 322500** F **01865 327393**
E **enquire@frankham.com**
www.frankham.com

25 YEARS ANNIVERSARY 1982 - 2007

Client
Leadbitter CONSTRUCTION

Project Title
Whitehall Junior & Infant School
Refurbishment, Extension and New Build
Cowley Road
London Borough of Hillingdon

Drawing Title
New 4 Classroom Infant Block
Proposed Elevations
(Sheet 1 of 2)

Drawn by:	Scale:	Date:
RKC	1:100@A1	05.04.12
Designed by:	Checked by:	Approved by:
FCG	JAS	AGC

File Ref...X:\000000\611869 - HILLINGDON SCHOOLS - WHITEHALL REDESIGN\ARCH\300_399_ELEVATIONS\611869-A-300.DWG - REV:- 14/04/12 14:04:24:10.42-47

Drawing No.	Rev.
611869-A-300	-