01 Elevation 1 - Proposed
Scale: 1:100

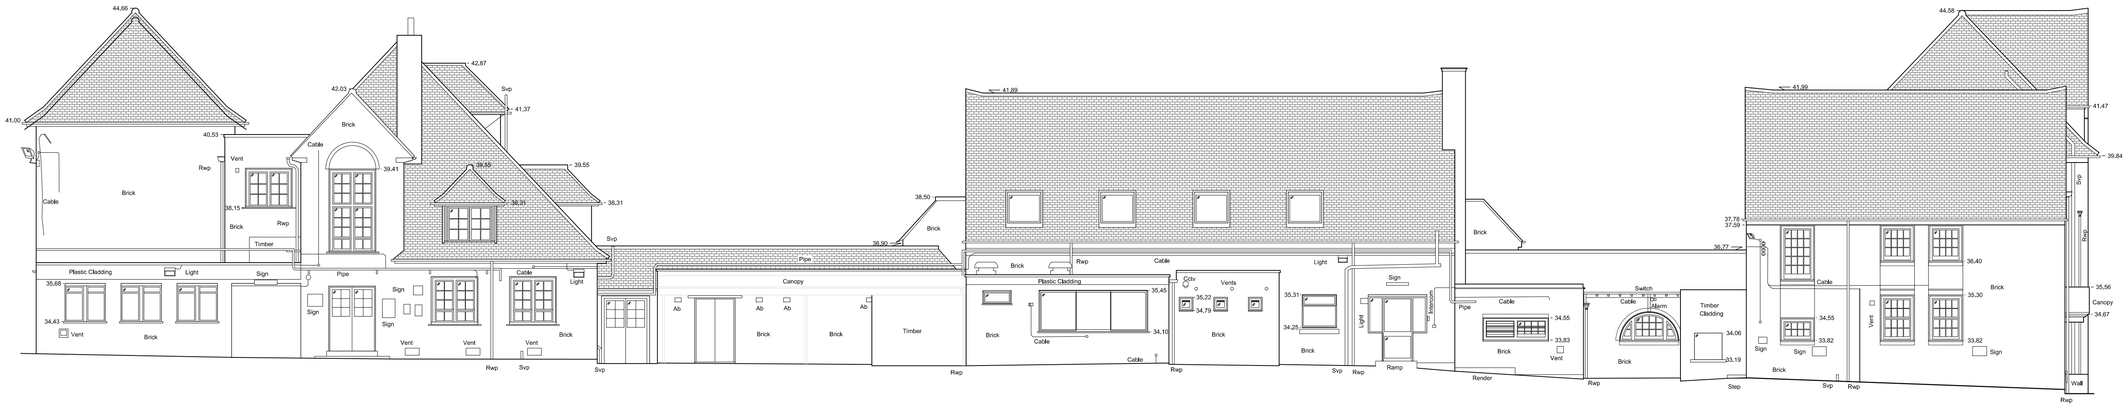

02 Elevation 3 - Proposed
Scale: 1:100

NOTES: Do not scale this drawing. All dimensions to be checked on site prior to commencement or manufacture.

NB: All information based on supplied third party survey information. All discrepancies to be reported to FCG immediately upon discovery.

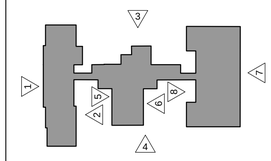

Scale Bar

0 2 4 6 1:100
0 2 4 6 8 10 12 1:200

AS BUILT DRAWING

Rev	Date	By	Chk	Comment
AB1	17.04.14	RKC	AGC	DRAWING ISSUED - AS BUILT

25 YEARS OF BRINGING IDEAS TO LIFE

25 YEARS ANNIVERSARY 1982 - 2007

FRANKHAM

Frankham Consultancy Group Limited
Frankham House Wootton Business Park
Besselsleigh Road Wootton Abingdon
Oxfordshire OX13 6FD
T **01865 322500** F **01865 327393**
E **enquire@frankham.com**
www.frankham.com

Client
Leadbitter CONSTRUCTION

Project Title
Whitehall Junior & Infant School
Refurbishment, Extension and New Build
Cowley Road
London Borough of Hillingdon

Drawing Title
Junior School
Existing Elevations
Sheet 1

Drawn by:	Scale:	Date:
RKC	1:100@A1	08.05.12
Designed by:	Checked by:	Approved by:
FCG	JAS	AC

File Ref..X:\000000\611869 - HILLINGDON SCHOOLS - WHITEHALL RECEIS\BOWARCH\200_3D_ELEVATIONS\611869-A-310.DWG - - REV-AB1-14\04\14\0833 14:04:24:10:43:05

Drawing No.	Rev.
611869-A-310	AB1