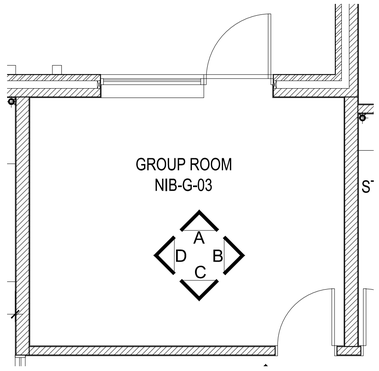

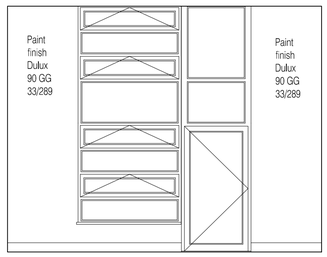

ELEVATION A
NIB-G-03 - GROUP ROOM

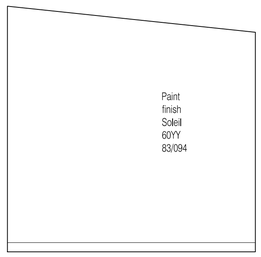

ELEVATION B
NIB-G-03 - GROUP ROOM

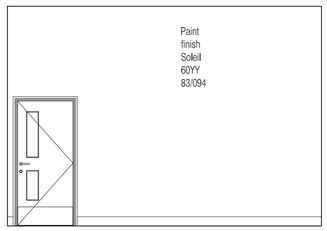

ELEVATION C
NIB-G-03 - GROUP ROOM

ELEVATION D
NIB-G-03 - GROUP ROOM

NOTES: Do not scale this drawing. All dimensions to be checked on site prior to commencement or manufacture.

AS BUILT DRAWING

Rev	Date	By	Chk	Comment
AB1	17.04.14	RKC	AGC	DRAWING ISSUED - AS BUILT

25 YEARS OF BRINGING IDEAS TO LIFE

FRANKHAM

Frankham Consultancy Group Limited
Frankham House Wootton Business Park
Besselsleigh Road Wootton Abingdon
Oxfordshire OX13 6FD
T 01865 322500 F 01865 327393
E enquire@frankham.com
www.frankham.com

ANNIVERSARY 25 YEARS 1982 - 2007

Client
Leadbitter CONSTRUCTION

Project Title
Whitehall Junior & Infant School
Refurbishment, Extension and New Build
Cowley Road
London Borough of Hillingdon

Drawing Title
New Infants Block
Proposed Room Elevations
Group Room

Drawn by:	Scale:	Date:
RKC	1:50@A1	15.04.13
Designed by:	Checked by:	Approved by:
FCG	JAS	AGC

File Ref.: X:\60000\611869 - HILLINGDON SCHOOLS - WHITEHALL REDESIGN\ARCH\300_399_ELEVATIONS\611869-A-346.DWG - REV AB1-14\04\14\04\17 14.04.24:10:45:20

Drawing No.	Rev.
611869-A-346	AB1