


01 Floor Plan
Scale: 1:50

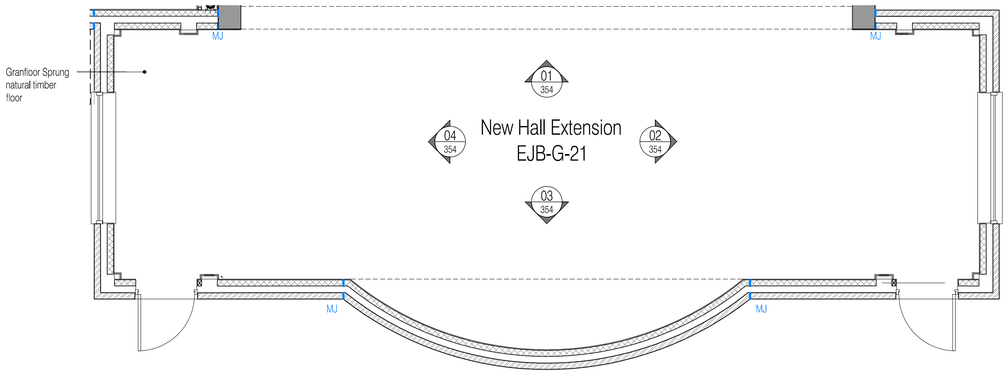


02 Elevation 01
Scale: 1:50




03 Elevation 02
Scale: 1:50

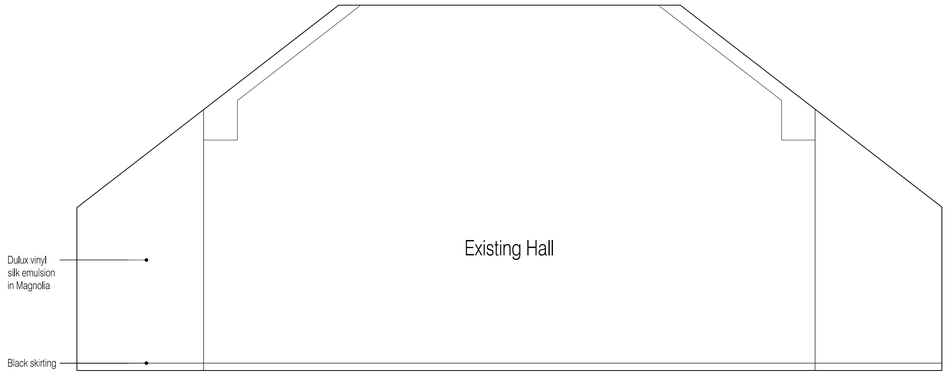


05 Elevation 04
Scale: 1:50

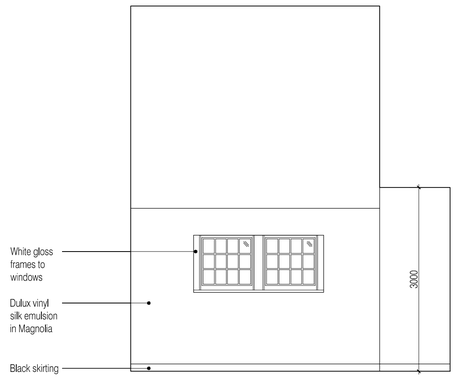


04 Elevation 03
Scale: 1:50

NOTES: Do not scale this drawing. All dimensions to be checked on site prior to commencement or manufacture.

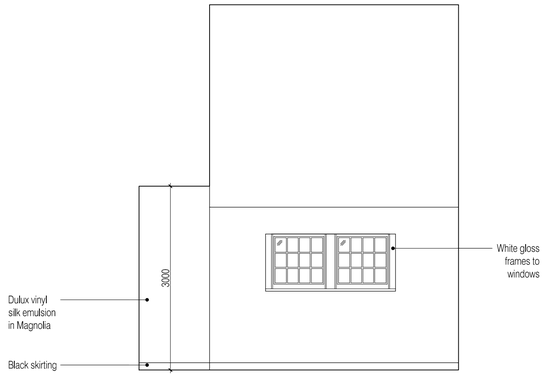NB: All information based on supplied third party survey information. All discrepancies to be reported to FCG immediately upon discovery.

AS BUILT DRAWING
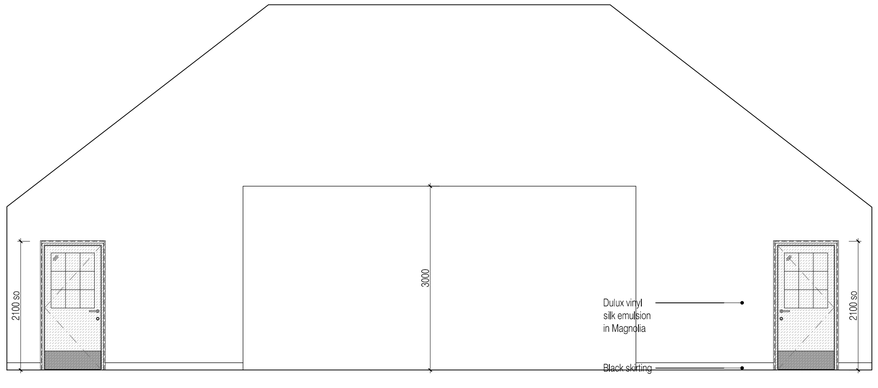
| Rev | Date | By | Chk | Comment |
|---|---|---|---|---|
| AB1 | 17.04.14 | RKC | AGC | DRAWING ISSUED - AS BUILT |

25 YEARS OF BRINGING IDEAS TO LIFE

FRANKHAM


Frankham Consultancy Group Limited
Frankham House Wootton Business Park
Besselsleigh Road Wootton Abingdon
Oxfordshire OX13 6FD
T 01865 322500 F 01865 327393
E enquire@frankham.com
www.frankham.com


ANNIVERSARY 25 YEARS 1982 - 2007

Client
Leadbitter CONSTRUCTION

Project Title
Whitehall Junior & Infant School
Refurbishment, Extension and New Build
Cowley Road
London Borough of Hillingdon

Drawing Title
Existing Junior School WC Area
Room Elevations - New Hall Extension
EJB-G-21

| Drawn by: | Scale: | Date: |
|---|---|---|
| RKC | 1:50@A1 | 09.07.12 |
| Designed by: | Checked by: | Approved by: |
| FCG | JAS | AC |

File Ref.: X:\600000\611869 - HILLINGDON SCHOOLS - WHITEHALL REDESIGN\ARCH\300_399_ELEVATIONS\611869-A-354.DWG - REV:AB1-14\04\04\04\06 14:04:24:10:45:59

Drawing No. 611869-A-354 Rev. AB1