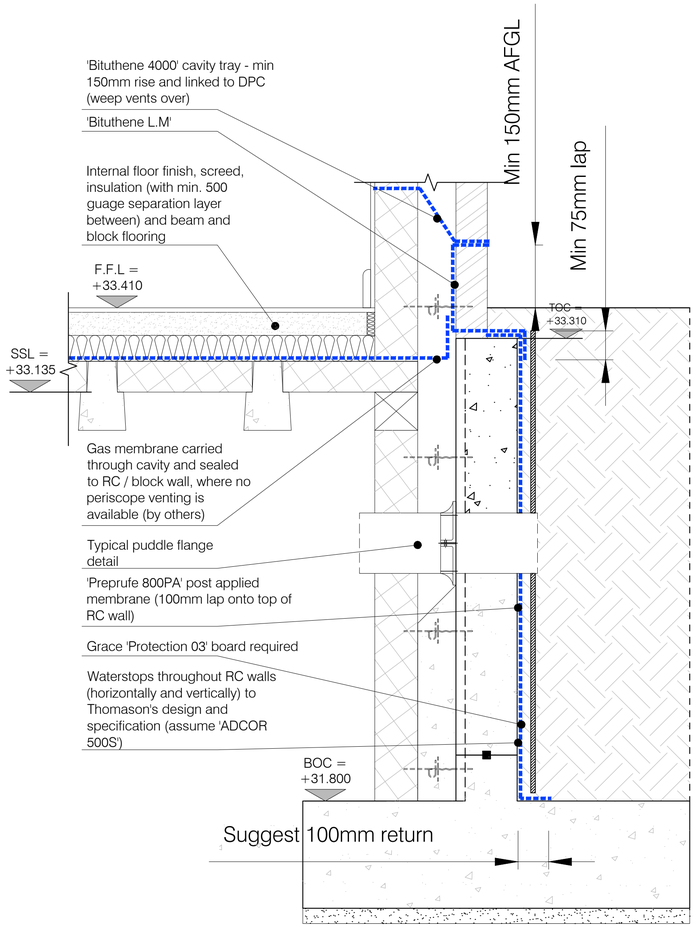

SECTION 3-3

(SCALE 1:10)

NOTE:
Locations of weep holes and cavity tray and membrane installation through wall stepped within brick course in response to rake of external stairs.

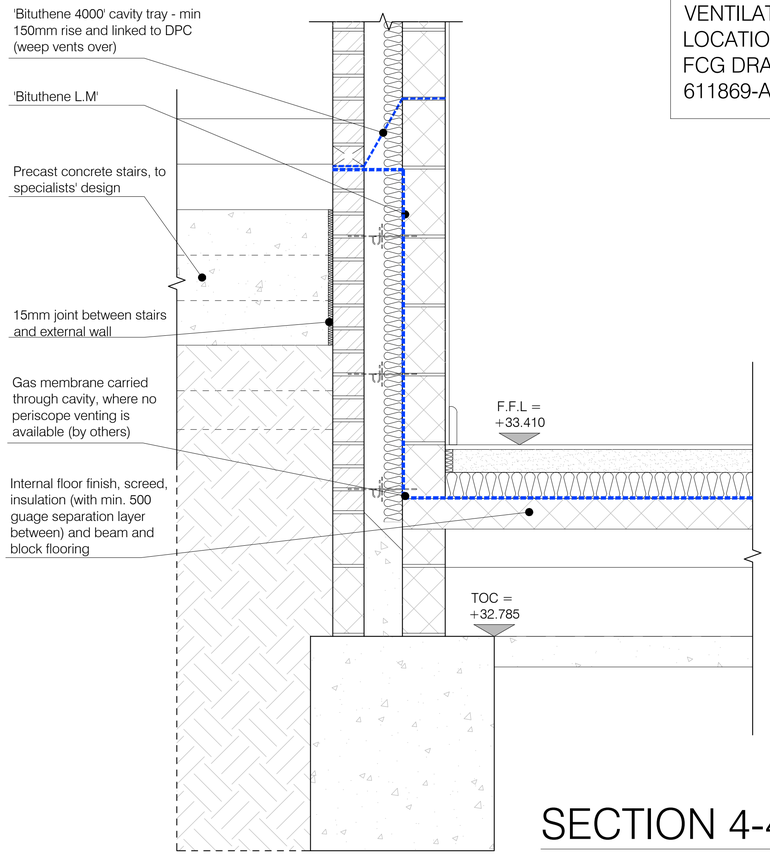

SECTION 4-4

(SCALE 1:10)

NOTE:-
NO SUB-FLOOR VENTILATIONS IN SUCH LOCATIONS (SEE ALSO FCG DRAWING 611869-A-192)

NOTES: Do not scale this drawing. All dimensions to be checked on site prior to commencement or manufacture.

AS BUILT DRAWING

Rev	Date	By	Chk	Comment
AB1	17.04.14	RKC	AGC	DRAWING ISSUED - AS BUILT

25 YEARS OF BRINGING IDEAS TO LIFE

FRANKHAM

Frankham Consultancy Group Limited

Frankham House Wootton Business Park
Besselsleigh Road Wootton Abingdon
Oxfordshire OX13 6FD
T **01865 322500** F **01865 327393**
E **enquire@frankham.com**
www.frankham.com

ANNIVERSARY 25 YEARS 1982 - 2007

Client
Leadbitter CONSTRUCTION

Project Title
Whitehall Junior & Infant School
Refurbishment, Extension and New Build
Cowley Road
London Borough of Hillingdon

Drawing Title
Waterproofing
Details - sheet 2 of 2

Drawn by:	Scale:	Date:
RKC	1:10@A1	13.02.13
Designed by:	Checked by:	Approved by:
FCG	JAS	AC

File Ref. X:\0000006\1\BIM~1\LJNCCH~1\SCHOOLS~1\WHITEHALL REDESIGN\ARCH\000_VIEWS\611869-A-513.DWG 14/04/24 10:50:37

Drawing No.	Rev.
611869-A-513	AB1